

KANSAS

Form 51—5M—7-40—Palace

McPherson

Section 18 Township 20 Range 5-W

Well No. #1 Peterson


Company Transwestern

Bornholdt Pool

NORTH

WEST

EAST

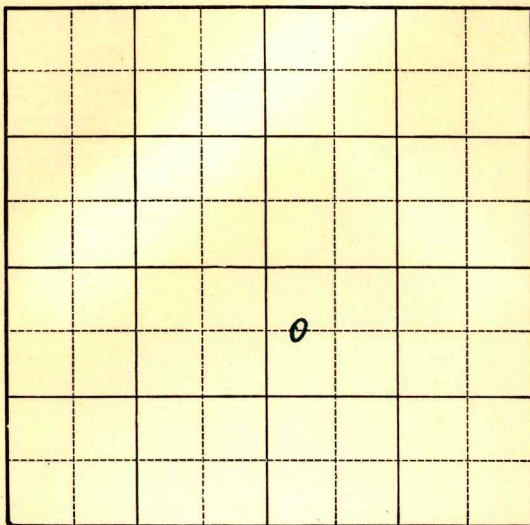

SOUTH

KANSAS

McPherson

Sec. 18 Twp. 20 R. 5-WWell No. #1 Peterson Farm

Transwestern

Company

(Bornholdt)

660

Ft. from N. Line


Ft. from S. Line

Ft. from E. Line

330

Ft. from W. Line

Elev. 1552

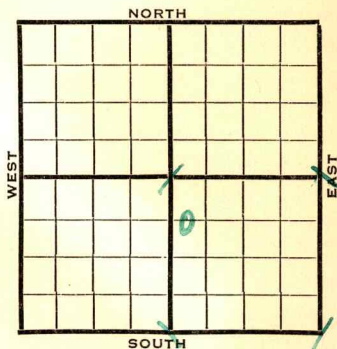

1940

REPORT

7/31

Bldg. Derrick.

8/8

" " "

8/14

Drlg. 3055'

8/22

Chat. 3318' 6" - 3320'

H.F.O. 3341-49' T.D.

8/28

Chat 3318

6" 3320

T.D. 3356

Bomb Pot. 12255

Max. 3000

COMPLETED

Map No. _____ Sec. 18 Twp. 20 R. 5W

Well No. 1 Peterson

Transwestern Company

Contractor

COMPLETED

C $W\frac{1}{2}$ NW SE

660 Ft. from N. Line

_____ Ft. from S. Line

_____ Ft. from E. Line

330 Ft. from W. Line

SECTION PLAT

		0	

BORNHOLDT POOL

Location _____

Rig up _____

Drilling and Remarks:

Chas 3318

6" @ 3320

Born + 28.12255

Max 3000

RECORD

Cased _____ in., _____ ft.

Sand _____

Gas _____

Oil _____

Total Depth 3356

PRODUCTION

1st 24 hrs. Nat. _____

1st 24 hrs. after shot _____

Gas _____ Cu. Ft.

Dry Hole _____

Abandoned _____

Date

AUG 28 1940

19

S. J. LEWIS Scout

Map No. 48 Sec. 18 Twp. 20 R. 5WWell No. 1 Peterson**Transwestern**


Company

Contractor

FIRST REPORT**C W $\frac{1}{2}$ NW SE****660** Ft. from N. Line

Ft. from S. Line

Ft. from E. Line

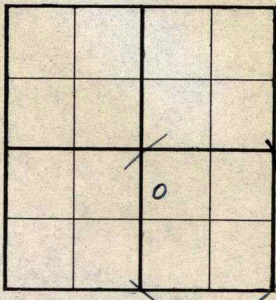330 Ft. from W. Line**BORNHOLDT POOL****SECTION PLAT**

Location _____

Rig up _____

Drilling and Remarks:

Bldg. Derrick**RECORD**

Cased _____ in., _____ ft.

Sand _____

Gas _____

Oil _____

Total Depth _____

PRODUCTION

1st 24 hrs. Nat. _____

1st 24 hrs. after shot _____

Gas _____ Cu. Ft.

Dry Hole _____

Abandoned _____

Date

JUL 31 1940₁₉S. J. LEWIS Scout