


Section 18 Township 20 Range 5-W

Well No. #2 Peterson

Company Transwestern

Bornholdt Pool

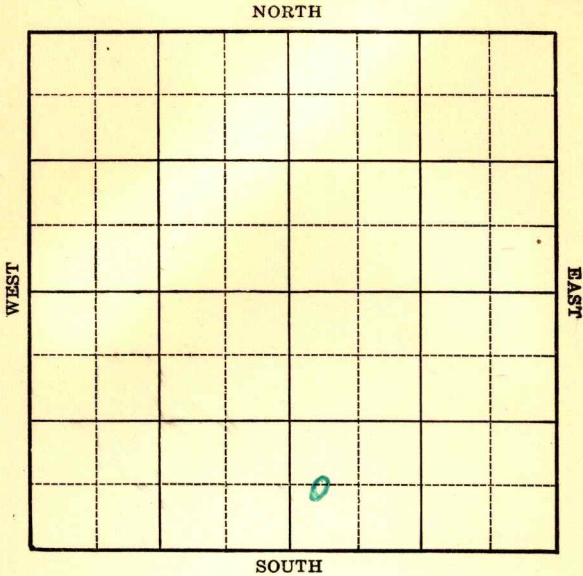


Sec. 18 Twp. 20 R. 5-WWell No. #2 Peterson FarmTranswestern Company

(Bornholdt)

 Ft. from N. Line660 Ft. from S. Line Ft. from E. Line330 Ft. from W. Line

Elev. 1536

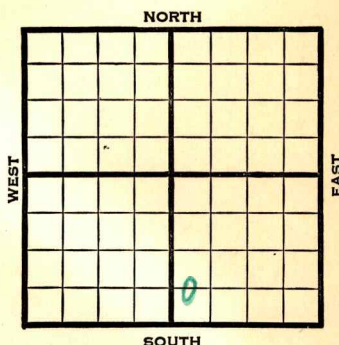

1940

REPORT

9/4

Rotary.

9/12

9" - 171' Drlg. 1910'

9/19

Chat. 3296-3303' T.D. Run 7".

9/26

7" - 3297' T.D. 3335'

Flow 121 bbls, 136 bbs. & 143

bbls. per hour.

10/2

Chat. 3296'

7" - 3297'

T.D. 3335'

Bomb potential 47,884 bbls.

Maximum 3000 bbls.

COMPLETED

Map No. 48 Sec. 18 Twp. 20 R. 5WWell No. 2 PetersonTranswestern Company

Contractor

FIRST REPORT

C W L SW SE

 Ft. from N. Line660 Ft. from S. Line Ft. from E. Line330 Ft. from W. Line

BORNHOLDT POOL

SECTION PLAT

		0	

Location Rig up

Drilling and Remarks:

Rotary

RECORD

Cased in., ft.Sand Gas Oil Total Depth

PRODUCTION

1st 24 hrs. Nat. 1st 24 hrs. after shot Gas Cu. Ft.Dry Hole Abandoned

Date

SEP 4 1940 19S. J. LEWIS Scout

Map No. 48 Sec. 18 Twp. 20 R. 5WWell No. 2 PetersonTranswestern Company

Contractor

COMPLETED

C W L SW SE

SECTION PLAT

		0	

 Ft. from N. Line660 Ft. from S. Line Ft. from E. Line330 Ft. from W. Line

BORNHOLDT POOL

Location Rig up

Drilling and Remarks:

*Chas 3296**7" @ 3297**Born & Ry 47884**May 3000***RECORD**Cased in., ft.Sand Gas Oil Total Depth 3335-**PRODUCTION**1st 24 hrs. Nat. 1st 24 hrs. after shot Gas Cu. Ft.Dry Hole Abandoned

Date

OCT 2 1940 19S. J. LEWIS Scout