

KANSAS

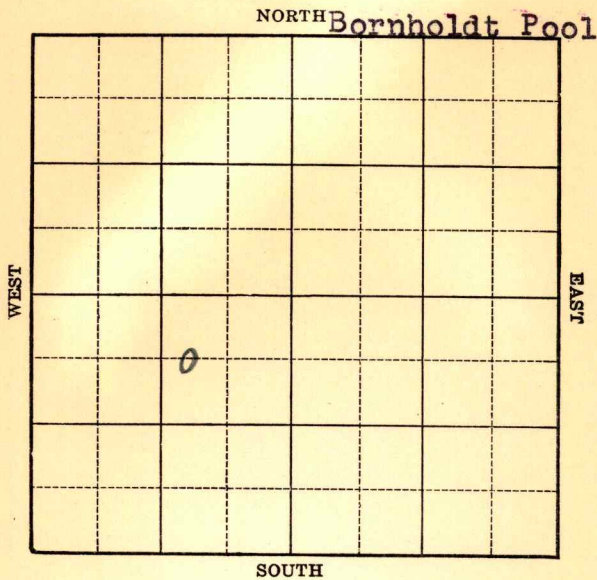
McPherson

Form 51—5M—7-39—Palace

Section 18 Township 20 Range 5-W

Well No. #3 Swanson

Company Republic Natural Gas.

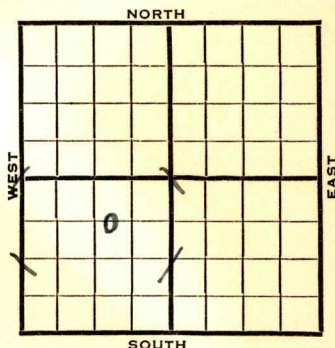


KANSAS

McPherson

Sec. 18 Twp. 20 R. 5 -WWell No. #3 Swanson FarmRepublic Natural Gas Company

(Bornholdt)

660 Ft. from N. Line Ft. from S. Line990 Ft. from E. Line Ft. from W. Line**Elev. 1555**

1940	REPORT
5/22	Derrick.
5/29	8" - 117' Drlg. 1980'
6/6	Drlg. 3300'
6/13	Chat. 3307' 5" - 3307'
	T.D. 3349' Flow 87 bbls. per hr
6/19	Chat. 3307'
	5" - 3307'
	T.D. 3349'
	Bomb potential 6800 bbls.
	Maximum 3000 bbls.

COMPLETED

Map No. 48 Sec. 18 Twp. 20 R. 5WWell No. 3 Swanson

Republic Natural Gas Company

Contractor

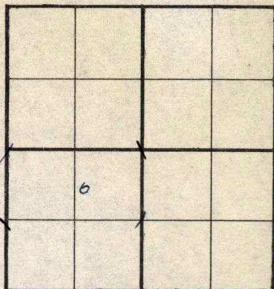
FIRST REPORT

C W L NE SW

660 Ft. from N. Line Ft. from S. Line990 Ft. from E. Line Ft. from W. Line

BORNHOLDT POOL

SECTION PLAT

Location Rig up

Drilling and Remarks:

Derrick

RECORD

Cased in., ft.Sand Gas Oil Total Depth

PRODUCTION

1st 24 hrs. Nat. 1st 24 hrs. after shot Gas Cu. Ft.Dry Hole Abandoned

Date

MAY 22 1940 19S. J. LEWIS Scout

Map No. 48 Sec. 18 Twp. 20 R. 5WWell No. 3 Swanson

Republic Natural Gas Company

Contractor

COMPLETED

C W L NE SW

660 Ft. from N. Line Ft. from S. Line990 Ft. from E. Line Ft. from W. Line

SECTION PLAT

	0		

BORNHOLDT POOL

Location Rig up

Drilling and Remarks:

*Cha 83307**5" 83307**Born 86800**Max 3000*

RECORD

Cased in., ft.Sand Gas Oil Total Depth 3349

PRODUCTION

1st 24 hrs. Nat. 1st 24 hrs. after shot Gas Cu. Ft.Dry Hole Abandoned

Date

JUN 19 1940 19

S. J. LEWIS Scout