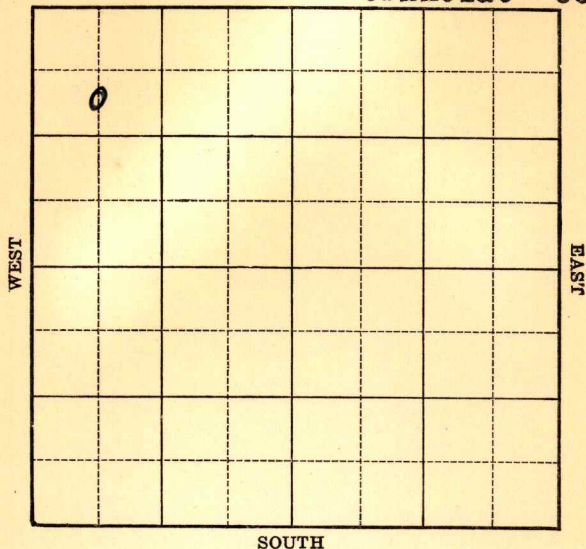


Section 18 Township 20 Range 5-WWell No. #2 SwansonCompany Central Petr. & Rose SpringDrilling NORTH Bornholdt Pool


KANSAS

McPherson

Sec. 18 Twp. 20 R. 5-WWell No. #2 Swanson Farm

Central Petr. & Rose Spring Drlg. Company

(Bornholdt)

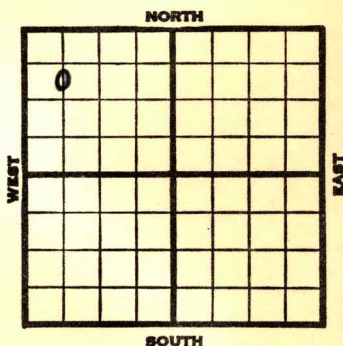990 Ft. from N. Line Ft. from S. Line Ft. from E. Line660 Ft. from W. Line

Elev. 1550

1940	REPORT
2/7	Derrick.
2/15	8" - 194' b Drlg. 1300'
2/23	Drlg. 2250'
2/29	Drlg. 3210'
3/8	Miss. 3295-3309' T.D. S.S.O.
	5" - 3299'
3/14	T.D. 3319' Flow by heads.
	Shut down.
3/21	T.D. 3360' Flow 30 bbls. per
	hour. Run tubing.
3/27	Chat. 3295'
	5" - 3299'
	T.D. 3360'
	Bomb potential 1511 bbls.
	COMPLETED

Map No. 23 Sec. 18 Twp. 20 R. 5WWell No. 2 Swanson

Central Petroleum & Company
 Rose Spring Drilling
 Contractor

FIRST REPORT

SECTION PLAT

C S L NW NW

990 Ft. from N. Line

Ft. from S. Line

Ft. from E. Line

660 Ft. from W. Line

BORNHOLDT POOL

Location _____

Rig up _____

Drilling and Remarks:

Derrick

RECORD

Cased _____ in., _____ ft.

Sand _____

Gas _____

Oil _____

Total Depth _____

PRODUCTION

1st 24 hrs. Nat. _____

1st 24 hrs. after shot _____

Gas _____ Cu. Ft.

Dry Hole _____

Abandoned _____

Date

FEB 7 1940 19

S. J. LEWIS

Scout

Map No. 48 Sec. 18 Twp. 20 R. 5WWell No. 2 SwansonCentral Petroleum & _____ Company
Rose Spring Drlg. Contractor

COMPLETED

SECTION PLAT

o			

C S L NW NW

990 Ft. from N. Line

_____ Ft. from S. Line

_____ Ft. from E. Line

660 Ft. from W. Line

BORNHOLDT POOL

Location _____

Rig up _____

Drilling and Remarks:

*Cha 83295**5" @ 3299**Born & B 1511*

RECORD

Cased _____ in., _____ ft.

Sand _____

Gas _____

Oil _____

Total Depth 3360

PRODUCTION

1st 24 hrs. Nat. _____

1st 24 hrs. after shot _____

Gas _____ Cu. Ft.

Dry Hole _____

Abandoned _____

Date

MAR 27 1940 19

S. J. LEWIS

Scout