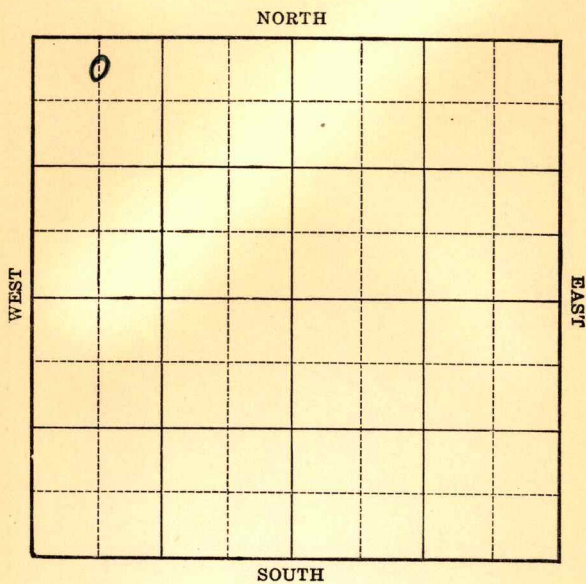


Section 19 Township 20 Range 5-WWell No. #1 JohnsonCompany Republic Natural Gas

KANSAS

McPherson

Sec. 19 Twp. 20 R. 5-WWell No. #1 Johnson FarmRepublic Natural Gas Company

(Bornholdt)


330 Ft. from N. Line

Ft. from S. Line

Ft. from E. Line

660 Ft. from W. Line

Elev. 1548

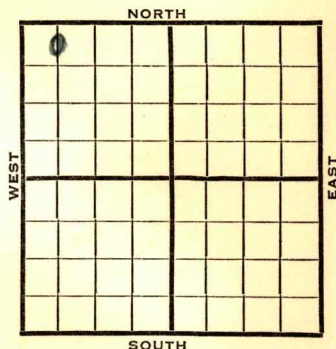

1940

REPORT

4/3 8" - 107' WOC.

4/12 T.D. 2817' sand.

4/18 Chat. 3288' T.D. 3301'

5" - 3390' RUST.

4/25 Pay 3325' Drlg. 3340'

5/2 T.D. 3348' Flow by heads.

Testing.

5/8 Chat. 3288'

5" @ 3290'


Total depth 3348'

Flow 225 bbls potential

COMPLETED

Map No. 48 Sec. 19 Twp. 20 R. 5WWell No. 1 JohnsonRepublic Natural Gas Company

Contractor

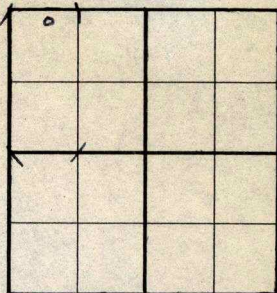FIRST REPORT**C N L NW NW**330 Ft. from N. Line Ft. from S. Line Ft. from E. Line660 Ft. from W. Line**SECTION PLAT****BORNHOLDT POOL**Location Rig up

Drilling and Remarks:

8" - 107**WOC****RECORD**Cased in., ft.Sand Gas Oil Total Depth **PRODUCTION**1st 24 hrs. Nat. 1st 24 hrs. after shot Gas Cu. Ft.Dry Hole Abandoned

Date

APR 3 1940 19S. J. LEWIS Scout

Map No. 48 Sec. 19 Twp. 20 R. 5WWell No. 1 JohnsonRepublic Natural Gas Company

Contractor

COMPLETED330 C N L NW NW
Ft. from N. Line

Ft. from S. Line

Ft. from E. Line

660 Ft. from W. Line**BORNHOLDT POOL****SECTION PLAT**

0			

Location _____

Rig up _____

Drilling and Remarks:

*Ok 8 3258**5" C 3290**Flow 225 Pk.***RECORD**

Cased _____ in., _____ ft.

Sand _____

Gas _____

Oil _____

Total Depth 3348**PRODUCTION**

1st 24 hrs. Nat. _____

1st 24 hrs. after shot _____

Gas _____ Cu. Ft.

Dry Hole _____

Abandoned _____

Date

MAY 8 1940 19S. J. LEWIS Scout