

KANSAS

McPherson

Form 51-5M-7-39-Palace

Section 19 Township 20 Range 5-W

Well No. #1 Linguist


Company Ohio

Bornholdt Pool

NORTH

WEST

EAST

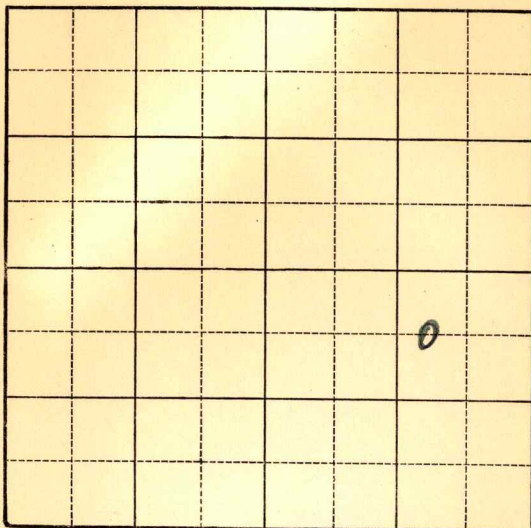

SOUTH

Company


Ft. from N. Line

Ft. from S. Line

Ft. from E. Line

Ft. from W. Line

Elev. 1549

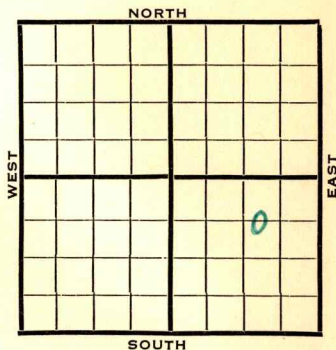

1940	REPORT
5/1	Location
5/9	Surface hole.
5/16	8" - 160' Drlg. 2174'
5/23	Chat. 3321½' T.D. 3330'
	5" - 3321½' RUST.
5/29	" " "
6/5	Chat. 3321½'
	5" - 3321½'
	T.D. 3365'
	Bomb potential 12,560 bbls.
	Maximum 3000 bbls.
	COMPLETED

Map No. 48 Sec. 19 Twp. 20 R. 5WWell No. 1 LinguistOhio


Company

Contractor

FIRST REPORT

C W L N E S E

SECTION PLAT

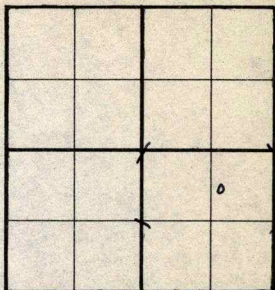660 Ft. from N. Line Ft. from S. Line990 Ft. from E. Line Ft. from W. Line

BORNHOLDT POOL

Location XRig up

Drilling and Remarks:

RECORD

Cased in., ft.Sand Gas Oil Total Depth

PRODUCTION

1st 24 hrs. Nat. 1st 24 hrs. after shot Gas Cu. Ft.Dry Hole Abandoned

Date

MAY 1 1940S. J. LEWIS

Scout

Map No. 48 Sec. 19 Twp. 20 R. 5WWell No. 1 Linguist
Ohio

Company

Contractor

COMPLETED

C W L NE SE

SECTION PLAT

			0

660 Ft. from N. Line

Ft. from S. Line

990 Ft. from E. Line

Ft. from W. Line

BORNHOLDT POOL

Location

Rig up

Drilling and Remarks:

*Chas 3321 1/2**5" C 3321 1/2**Born 12560 Pst**Max 3000*

RECORD

Cased _____ in., _____ ft.

Sand _____

Gas _____

Oil _____

Total Depth 3365

PRODUCTION

1st 24 hrs. Nat. _____

1st 24 hrs. after shot _____

Gas _____ Cu. Ft.

Dry Hole _____

Abandoned _____

Date

JUN 5 1940 19

S. J. LEWIS Scout