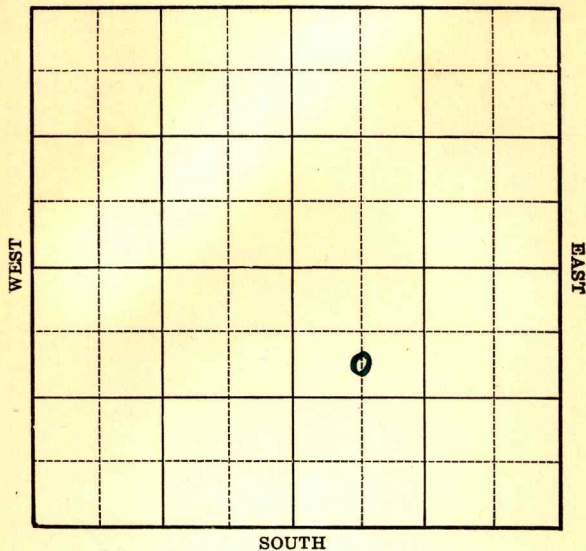


Section 19 Township 20 Range 5-WWell No. #3 LindquistCompany Ohio OilNORTH Bornholdt Pool

KANSAS

McPherson

FORM 252-A 5M 2-40

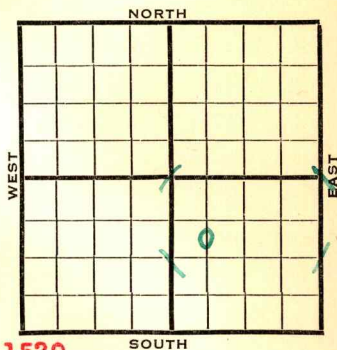
Sec. 19 Twp. 20 R. 5-WWell No. #3 Lindquist FarmOhio Oil Company

(Bornholdt)

990 Ft. from N. Line

Ft. from S. Line

Ft. from E. Line

660 Ft. from W. Line

Elev. 1529

SOUTH

1940	REPORT				
7/31	Location				
8/8	8" - 148'				
	Drig. 1949'				
8/14	Chat. 3283-89 T.D.				
	5" 3286 WOC				
8/22	T.D. 3323' Flow 21 bbls. per hr.				
8/29	"	"	"	"	"
9/5	"	"	"	"	"
9/12	"	"	"	"	"
9/19	"	"	"	"	"
9/26	"	"	"	"	"
10/2	Chat. 3283'				
	5" - 3286'				
	T.D. 3323'				
	Potential 233 bbls., flow.				
	COMPLETED				

Map No. 48 Sec. 19 Twp. 20 R. 5WWell No. 3-LindquistOhio Oil

Company

Contractor

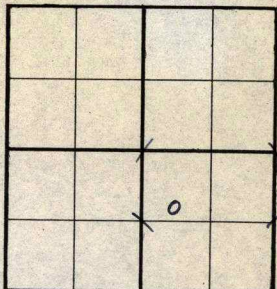
FIRST REPORT

C S L NW SE

SECTION PLAT

990 Ft. from N. Line Ft. from S. Line Ft. from E. Line660 Ft. from W. Line

BORNHOLDT POOL

Location XRig up

Drilling and Remarks:

RECORD

Cased in., ft.Sand Gas Oil Total Depth

PRODUCTION

1st 24 hrs. Nat. 1st 24 hrs. after shot Gas Cu. Ft.Dry Hole Abandoned

Date

JUL 31 1940 19S. J. LEWIS

Scout

Map No. 48 Sec. 19 Twp. 20 R. 5WWell No. 3 LindquistOhio Oil Company

Contractor

COMPLETED

C S L NW SE

990 Ft. from N. Line Ft. from S. Line Ft. from E. Line660 Ft. from W. Line

BORNHOLDT POOL

SECTION PLAT

Location Rig up

Drilling and Remarks:

*Cha 83283**5" 3286**Flow 233 28.*

RECORD

Cased in., ft.Sand Gas Oil Total Depth 3323

PRODUCTION

1st 24 hrs. Nat. 1st 24 hrs. after shot Gas Cu. Ft.Dry Hole Abandoned

Date

OCT 2 1940 19 S. J. LEWIS Scout