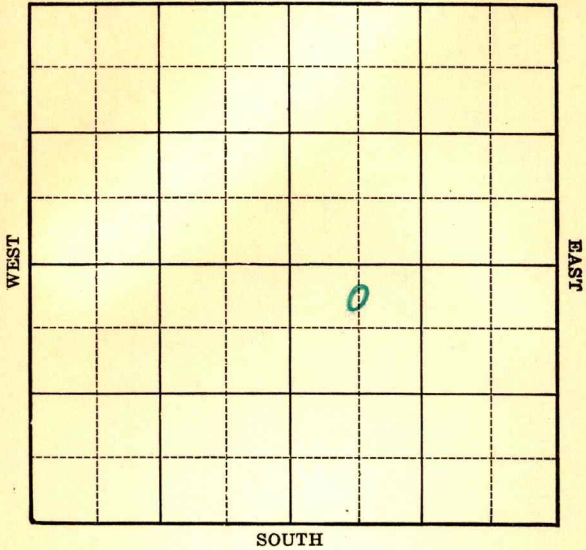


Section 19 Township 20 Range 5-W

Well No. #4 Lindquist

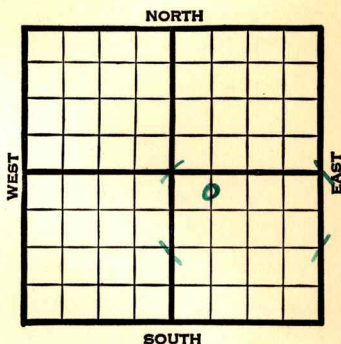
Company Ohio Oil

NORTH Bornholdt Pool



Company

Elev. 1530

[illegible]

Map No. 48 Sec. 19 Twp. 20 R. 5WWell No. 4 LindquistOhio Oil Company

Contractor

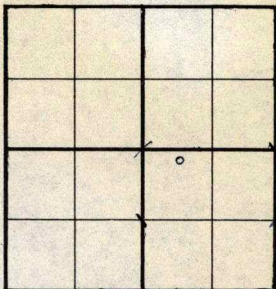
FIRST REPORT

C N L NW SE

330 Ft. from N. Line Ft. from S. Line Ft. from E. Line660 Ft. from W. Line

BORNHOLDT POOL

SECTION PLAT

Location XRig up

Drilling and Remarks:

RECORD

Cased in., ft.Sand Gas Oil Total Depth

PRODUCTION

1st 24 hrs. Nat. 1st 24 hrs. after shot Gas Cu. Ft.Dry Hole Abandoned

Date

SEP 18 1940

19

S. J. LEWIS

Scout

Map No. 48 Sec. 19 Twp. 20 R. 5WWell No. 4 LindquistOhio Oil Company

Contractor

COMPLETED

C N L NW SE

330 Ft. from N. Line Ft. from S. Line Ft. from E. Line660 Ft. from W. Line

BORNHOLDT POOL

SECTION PLAT

		0	

Location Rig up

Drilling and Remarks:

Ok at 32794" @ 3286Bornholdt 5666Max 3000

RECORD

Cased in., ft.Sand Gas Oil Total Depth 3319

PRODUCTION

1st 24 hrs. Nat. 1st 24 hrs. after shot Gas Cu. Ft.Dry Hole Abandoned

Date

OCT 30 1940 19 S. J. LEWIS Scout