

KANSAS

McPherson


Form 51—5M—7-39—Palace

Section 19 Township 20 Range 5-W

Well No. #2 Lindquist

Company Ohio Oil

NORTH **Bornholdt Pool**

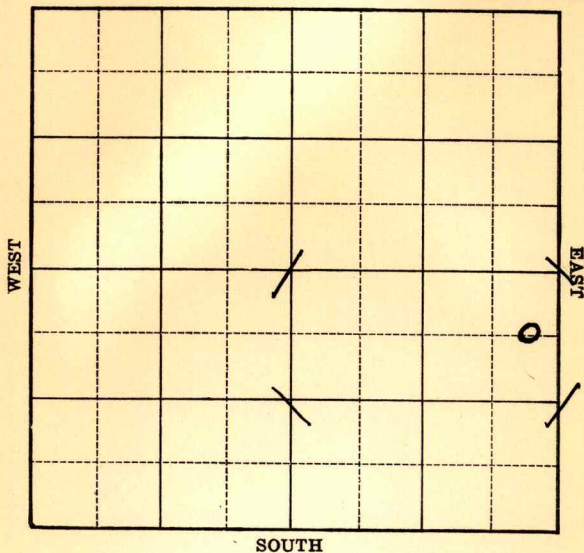

KANSAS

McPherson

Sec. 19 Twp. 20 R. 5-WWell No. #2 Lindquist FarmOhio Oil

Company

(Bornholdt)

660


Ft. from N. Line

Ft. from S. Line

330

Ft. from E. Line

Ft. from W. Line

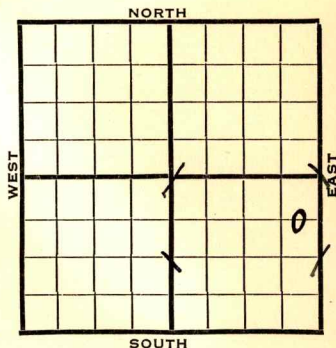**Elev. 1555**

1940

REPORT

6/5 8" - 168' WOC.

6/13 Drlg. 2890'

6/20 **Chat. 3339-40'** T.D. 5" - 3339'

6/27 3346' - 2000' oil.

3359' - H.F.O. T.D. 3378'

Flowing.

7/2 **Chat. 3339'**

5" - 3339'

T.D. 3380'

Bomb potential 1244 bbls.

COMPLETED

Map No. 48 Sec. 19 Twp. 20 R. 5WWell No. 2 LindquistOhio Oil Company

Contractor

FIRST REPORT

C E L N E S E

660 Ft. from N. Line660 Ft. from S. Line330 Ft. from E. Line Ft. from W. Line

SECTION PLAT

BORNHOLDT POOL

Location Rig up

Drilling and Remarks:

8" - 168'

WOC

RECORD

Cased in., ft.Sand Gas Oil Total Depth

PRODUCTION

1st 24 hrs. Nat. 1st 24 hrs. after shot Gas Cu. Ft.Dry Hole Abandoned

Date

JUN 5 1940 19S. J. LEWIS Scout

Map No. 48 Sec. 19 Twp. 20 R. 5WWell No. 2 LindquistOhio Oil

Company

Contractor

COMPLETED

C E L N E S E

660 Ft. from N. Line Ft. from S. Line330 Ft. from E. Line Ft. from W. Line

BORNHOLDT POOL

SECTION PLAT

			0

Location Rig up

Drilling and Remarks:

*Cha 83339**5" @ 3339**Born + Po 8 1244***RECORD**Cased in., ft.Sand Gas Oil Total Depth 3380**PRODUCTION**1st 24 hrs. Nat. 1st 24 hrs. after shot Gas Cu. Ft.Dry Hole Abandoned

Date

JUL 2 1940

19

S. J. LEWIS Scout