

KANSAS

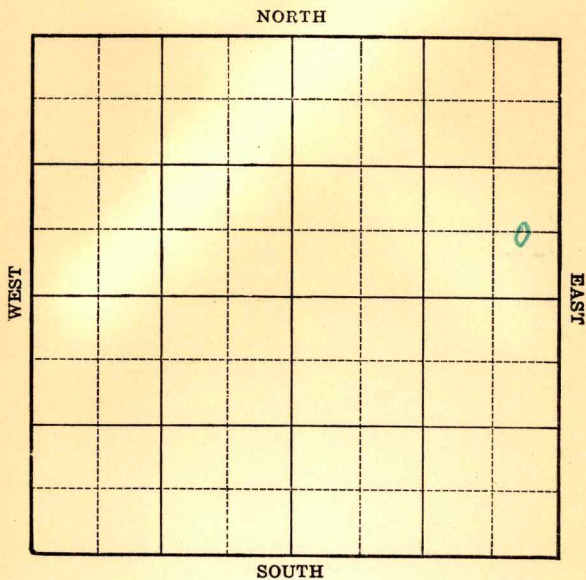
Form 51-5M-7-39-Palace

McPherson

Section 19 Township 20 Range 5W

Well No. #2 Nelson

Company Transwestern



KANSAS

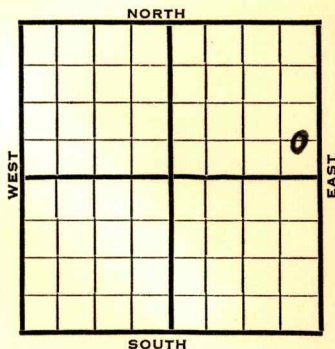
McPherson

FORM 252-A 5M 2-40

Sec. 19 Twp. 20 R. 5-WWell No. #2 Nelson FarmTranswestern

Company

(Bornholdt)

 Ft. from N. Line660 Ft. from S. Line320 Ft. from E. Line Ft. from W. Line**Elev. 1555**

1940

REPORT

7/10

Derrick.

7/18

Surface hole.

7/25

9" - 164' Drlg. 2220'

8/2

Miss. 3337-39' T.D. 6" - 3339'

8/8

Drlg. 3377' H.F.O.

8/14

Chat. 3337'

6" - 3339'

T.D. 3387'

Bomb potential 13,340 bbls.

Maximum 3000 bbls.

COMPLETED

Map No. _____ Sec. 19 Twp. 20 R. 5WWell No. 2 Nelson

Transwestern _____ Company

Contractor _____

FIRST REPORT

C E L S E N E

_____ Ft. from N. Line

660 Ft. from S. Line320 Ft. from E. Line

_____ Ft. from W. Line

SECTION PLAT

			0

BORNHOLDT POOL

Location _____

Rig up _____

Drilling and Remarks:
Derrick

RECORD

Cased _____ in., _____ ft.

Sand _____

Gas _____

Oil _____

Total Depth _____

PRODUCTION

1st 24 hrs. Nat. _____

1st 24 hrs. after shot _____

Gas _____ Cu. Ft.

Dry Hole _____

Abandoned _____

Date

JUL 10 1940

19

S. J. LEWIS Scout

Map No. 48 Sec. 19 Twp. 20 R. 5WWell No. 2 NelsonTranswestern Company

Contractor

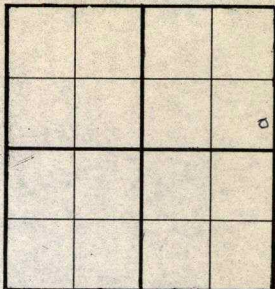
COMPLETED

C E L S E N E

 Ft. from N. Line660 Ft. from S. Line330 Ft. from E. Line Ft. from W. Line

BORNHOLDT POOL

SECTION PLAT

Location Rig up

Drilling and Remarks:

*Chas Y 3337**6" @ 3339**Born & P Y 13340**Max 3000*

RECORD

Cased in., ft.Sand Gas Oil Total Depth 3387

PRODUCTION

1st 24 hrs. Nat. 1st 24 hrs. after shot Gas Cu. Ft.Dry Hole Abandoned

Date

AUG 14 1940 19

S. J. LEWIS Scout