


Form 51—5M—7-40—Palace

Section 19 Township 20 Range 5W

Well No. #4 Nelson

Company Tulsa Oil

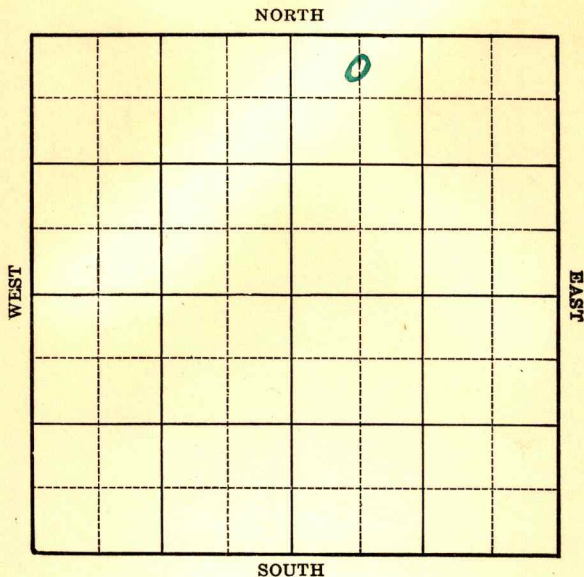

Sec. 19 Twp. 20 R. 5-W

Well No. #4 Nelson Farm

Tulsa Oil

Company

(Bornholdt)


330 Ft. from N. Line

_____ Ft. from S. Line

_____Ft. from E. Line

660 Ft. from W. Line

Elev. 1535

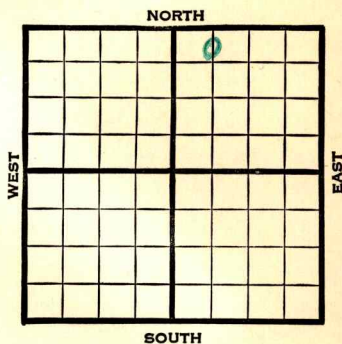[illegible]

Map No. 48 Sec. 19 Twp. 20 R. 5WWell No. 4 NelsonTulsa Oil

Company

FIRST REPORT

Contractor

C N L NW NE

SECTION PLAT

330 Ft. from N. Line Ft. from S. Line Ft. from E. Line660 Ft. from W. Line

BORNHOLDT POOL

		o	

Location Rig up

Drilling and Remarks:

Derrick

RECORD

Cased in., ft.Sand Gas Oil Total Depth

PRODUCTION

1st 24 hrs. Nat. 1st 24 hrs. after shot Gas Cu. Ft.Dry Hole Abandoned

Date

OCT 16 1940

19S. J. LEWIS

Scout

Map No. 48 Sec. 19 Twp. 20 R. 5WWell No. 4 NelsonTulsa Oil

Company

Contractor

COMPLETED

C N L NW NE

330 Ft. from N. Line Ft. from S. Line Ft. from E. Line660 Ft. from W. Line

BORNHOLDT POOL

SECTION PLAT

		o	

Location Rig up

Drilling and Remarks:

*Chas 3299**5" @ 3306**P. 83385.**Born & Pot 1/3/3**36° Gr*

RECORD

Cased in., ft.Sand Gas Oil Total Depth 3351

PRODUCTION

1st 24 hrs. Nat. 1st 24 hrs. after shot Gas Cu. Ft.Dry Hole Abandoned

Date

DEC 4 1940

19

S. J. LEWIS

Scout