

McPherson


KANSAS

Section 19 Township 20 Range 5-W

Well No. #1 Nyquist

Company Cities Service Oil

NORTH Bornholdt Pool

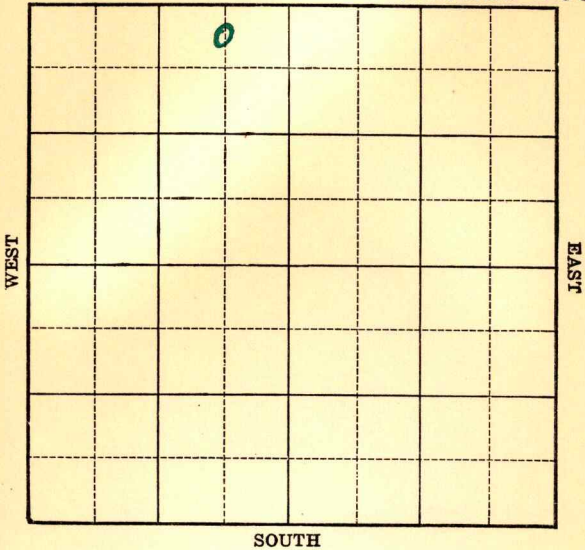

Sec. 19 Twp. 20 R. 5-W

Well No. #1 Nyquist Farm

Cities Service Oil

Company

(Bornholdt)

330

Ft. from N. Line


Ft. from S. Line

660

Ft. from E. Line

Ft. from W. Line

Elev. 1548

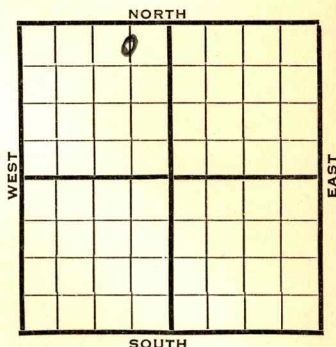

1940

REPORT

7 / 24

Derrick.

8/2

8" - 188' Drlg. 1590'

8/8

Chat. 3294' 5" - 3296' RUST.

8/14

T.D. 3395' 1000' fluid

26 $\frac{1}{2}$ hrs. 50% W.P.B. 3345 WOC

8/21

Chat. 3295'

5" - 3297'

T.D. 3395'

P.B. to 3345'

Potential 34 bbls., pump.

COMPLETED

Map No. _____ Sec. **19** Twp. **20** R. **5W**Well No. **1 Nyquist****Cities Service Oil** Company

Contractor

FIRST REPORT**SECTION PLAT****C N L NE NW**
330 _____ Ft. from N. Line

_____ Ft. from S. Line

660 _____ Ft. from E. Line

_____ Ft. from W. Line

BORNHOLDT POOL

	o		

Location _____

Rig up _____

Drilling and Remarks:

Derrick**RECORD**

Cased _____ in., _____ ft.

Sand _____

Gas _____

Oil _____

Total Depth _____

PRODUCTION

1st 24 hrs. Nat. _____

1st 24 hrs. after shot _____

Gas _____ Cu. Ft.

Dry Hole _____

Abandoned _____

Date

JUL 24 1940 19**S. J. LEWIS** Scout

Map No. _____ Sec. 19 Twp. 20 R. 5WWell No. 1 NyquistCities Service Oil Company

Contractor _____

COMPLETED

SECTION PLAT

330 C N L NE NW
Ft. from N. Line

____ Ft. from S. Line

660 Ft. from E. Line

____ Ft. from W. Line

BORNHOLDT POOL

Location _____

Rig up _____

Drilling and Remarks:

*Cha 3295**5" C 3297**PB 3345**Pump 84 1/2 Hk Pk.*

RECORD

Cased _____ in., _____ ft.

Sand _____

Gas _____

Oil _____

Total Depth 3395

PRODUCTION

1st 24 hrs. Nat. _____

1st 24 hrs. after shot _____

Gas _____ Cu. Ft.

Dry Hole _____

Abandoned _____

Date

AUG 21 1940

19

S. J. LEWIS Scout