


Rice

KANSAS

Section 2 Township 20 Range 8-W

Well No. 1 Brubaker

Company Spring-Rose

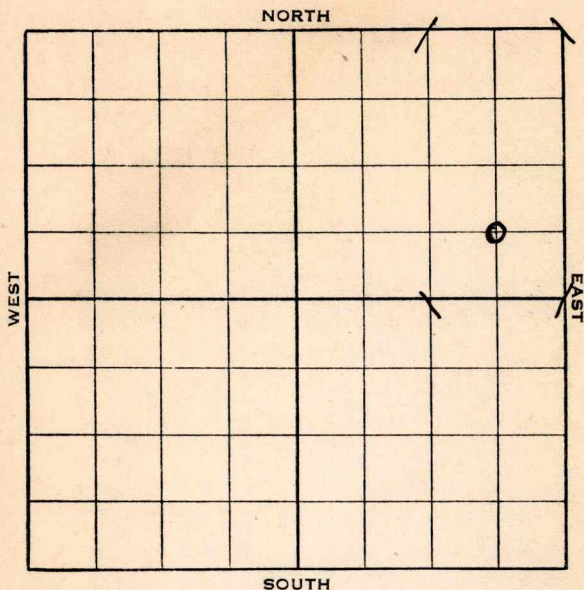

Sec. 2 Twp. 20 R. 8-W

Well No. #1 Brubaker Farm


Spring-Rose Company

_____ Ft. from N. Line

660 Ft. from S. Line

660 Ft. from E. Line

_____ Ft. from W. Line

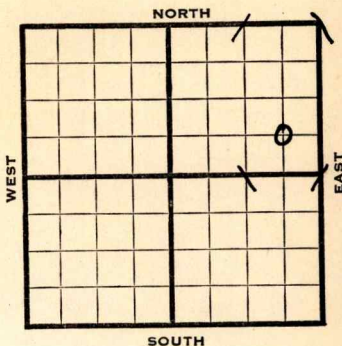

Elev. 1709

REPORT

1938	
8/31	R. R.
9/9	"
9/16	12" - 114'. Dlg. 1545'.
9/23	Dlg. 3000'.
9/30	Arb. 3297'. T.D. 3299'.
	8" - 3297'. RUST.
	No shows reported.
10/7	T.D. 3330'. Est. 16 to 20 M gas.
10/14	" " " " " "
10/21	" " " " " "
10/26	8" - 3297'.
	Arb. 3297'.
	T. D. 3330'.
	10½ M sour gas.
	Rock pressure 1050#.

COMPLETED

Rice

KANSAS

Map No. 49 Sec. 2 Twp. 20 R. 8W

Well No. 1 Brubaker

Spring-Rose

F.O. Company

Contractor

FIRST REPORT

C SE NE

_____ Ft. from N. Line

660 Ft. from S. Line

660 Ft. from E. Line

_____ Ft. from W. Line

SECTION PLAT

			0

Location _____

Rig up _____

Drilling and Remarks:

RR

RECORD

Cased _____ in., _____ ft.

Sand _____

Gas _____

Oil _____

Total Depth _____

PRODUCTION

1st 24 hrs. Nat. _____

1st 24 hrs. after shot _____

Gas _____ Cu. Ft.

Dry Hole _____

Abandoned _____

Date

AUG 31 1938

19

H. D. Hatfield Scout

Map No. 49 Sec. 2 Twp. 20 R. 8W

Well No. 1-Brubaker

Spring-Rose Company

Contractor

C SE NE

COMPLETED

SECTION PLAT

			0

 Ft. from N. Line

660 Ft. from S. Line

660 Ft. from E. Line

 Ft. from W. Line

Location

Rig up

Drilling and Remarks:

10 1/2 M ^{sour} gas
Rock Pres
1050 #

RECORD

Cased 8 in., 3297 ft.

Sand ARB 3297

Gas

Oil

Total Depth 3320

PRODUCTION

1st 24 hrs. Nat.

1st 24 hrs. after shot

Gas Cu. Ft.

Dry Hole

Abandoned

Date

OCT 26 1938 19

H. D. Hatfield

Scout