


McPherson KANSAS

Map No. _____ Sec. 2 Twp. 20 R. 3^W

Well No. 1- Bridgens Farm
Turnman oil Company

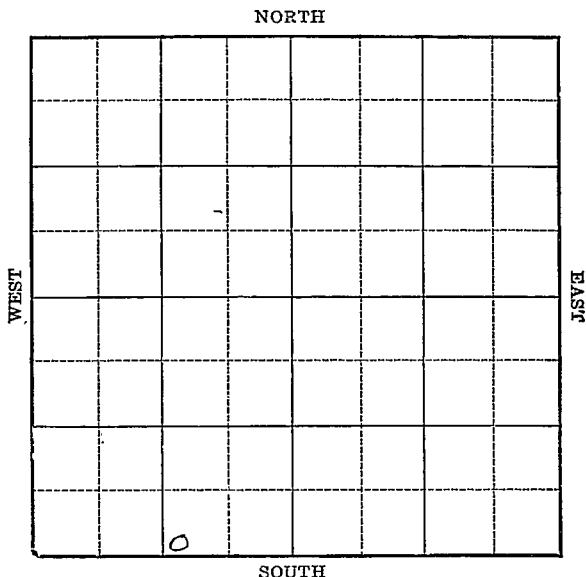

Location _____
 Drilling Remarks _____

Rig Up _____
 Drilling Remarks _____

RECORD

Cased _____ in. _____ ft.
 Sand _____
 Gas _____
 Oil _____
 Total Depth _____

PRODUCTION

1st 24 hrs. Nat. _____
 1st 24 hrs. after shot _____
 Gas _____ cu. ft.
 Dry Hole _____
 Abandoned _____

McPherson

Form 252-A
5M 4-32 MPC

Map No. KANSAS Sec. 2 Twp. 20 R. 3 W

Well No. 1 Budgens Farm


Sumner Oil Co. Company

 Ft. from N. Line

330' Ft. from S. Line

990' Ft. from E. Line

 Ft. from W. Line

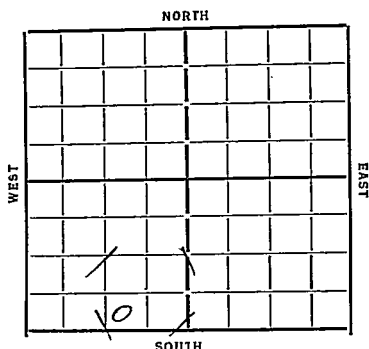

Date: 1933

REPORT

4/26 Location

5/4 Rig

5/10 15" 206' dely 1775'

5/17 dely 2805'

5/24 Top Chat 2978 Cement 8' 2981 Rust

6/1 Clearing Out

6/18 Top Chat 2981 Corrected T.D. 3048

Oil 3018'-40' eat 300 bbls dry swab & flow

6/15 —

6/21 Testing

6/28 Top chat 2981

T.D. 3048

75 bbls oil

2 % water

COMPLETED

McPherson

43 KANSAS Map No. Sec. 2 Twp. 20 R. 3

Well No. 1 Briggens Turman Oil Co. Company

Contractor

FIRST REPORTS


Ft. from N. Line

330 Ft. from S. Line

990 Ft. from E. Line

Ft. from W. Line

SECTION PLAT

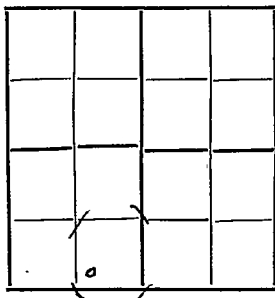

Location ✓

Rig up

Drilling and Remarks:

RECORD

Cased in., ft.

Sand

Gas

Oil

Total Depth

PRODUCTION

1st 24 hrs. Nat.

1st 24 hrs. after shot

Gas Cu. Ft.

Dry Hole

Abandoned

Date


APR 26 1933

CHAS. L. SHERWOOD

Scout

McPherson
Map No. _____ Sec. 2 Twp. 20 R. 3WWell No. 1-BridgensTurnman Oil & W Company_____
Contractor

SECTION PLAT

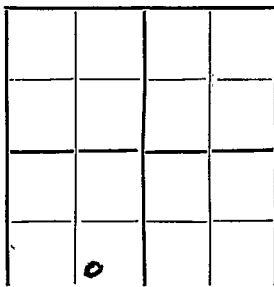Ft. from N. Line330 Ft. from S. Line990 Ft. from E. Line_____
Ft. from W. Line**COMPLETED**

Location _____

Rig up _____

Drilling and Remarks:

Chat 298175 bbls290 water

RECORD

Cased _____ in., _____ ft.

Sand _____

Gas _____

Oil _____

Total Depth 3048

PRODUCTION

1st 24 hrs. Nat. _____

1st 24 hrs. after shot _____

Gas _____ Cu. Ft.

Dry Hole _____

Abandoned _____

Date

6/28/33 192 Orval Mannick