

Form 51--5M--2-29--34703

Map No. **KANSAS** Sec. 2 Twp. 20 R. 3

Well No. 1 - Buddgens Farm

~~John W. Stevenson and~~ Company

NORTH

Gården et al

WEST

EAST

SOUTH

Location_____

Drilling Remarks

Rig Up

Drilling Remarks

RECORD

Cased_____in._____ft.

Sand_____

Gas_____

Oil

Total Depth-----

PRODUCTION

1st 24 hrs. Nat. _____

1st 24 hrs. after shot.-----

Gas cu. ft.

Dry Hole_____

Abandoned_____

Map No. **KANSAS** Sec. 2 Twp. 20 R. 3^W

Well No. 1-Bridgens Farm

~~John B. Brennan et al~~ Company

Garden et al


_____ Ft. from N. Line

990 Ft. from S. Line

_____ Ft. from E. Line

990 Ft. from W. Line

1932

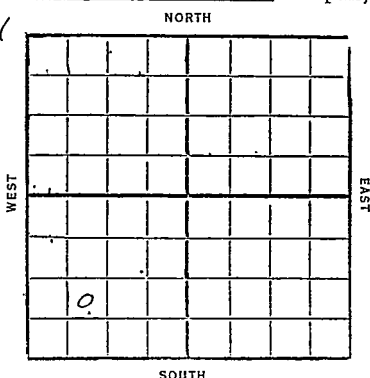

Date

REPORT

5/11 Loc

5/18
5/25 Rob

6/1 Rig
6/8 Spud & 517

6/15

6/22

6/29

7/6

7/13 20"-53
Fsg took 760'

7/20 12 1/2"-1503

7/27 10"-1792

8/3 dreg 1818'
HFw 2155

8"-2325

8/10 Dreg 2565

8/17 " 2752'

8/24 Chat 2973-86

show gas

Well cemo 5"

(over)

8/31. TD 3019

full up 2000' oil $1\frac{1}{2}$ hr
flowing by heads

9/7- TD 3019 shut in
No test

Big tankage

9/14. Chat 2973-3037

TD 3037

flow 225 bbl 24 hr
Comp.

43 KANSAS

Map No. _____ Sec. 7 Twp. 20 R. 3^w

Well No. 1

Bridgens
Jim Brennon & Co. Company

Contractor

FIRST REPORTS

_____ Ft. from N. Line

990 Ft. from S. Line

_____ Ft. from E. Line

990 Ft. from W. Line

SECTION PLAT

Location _____ ✓

Rig up _____

Drilling and Remarks: _____

RECORD

Cased _____ in., _____ ft.

Sand _____

Gas _____

Oil _____

Total Depth _____

PRODUCTION

1st 24 hrs. Nat. _____

1st 24 hrs. after shot _____

Gas _____ Cu. Ft.

Dry Hole _____

Abandoned _____

Date

MAY 1 1 1932

CHAS. L. SHERWOOD

192

Scout

McPherson

43 KANSAS

Map No. Sec. 2 Twp. 20 R. 3 W

Well No. *Briogens**Garden Ct #1*

Company

Contractor

CORRECTION


Ft. from N. Line

990 Ft. from S. Line

Ft. from E. Line

990 Ft. from W. Line

SECTION PLAT

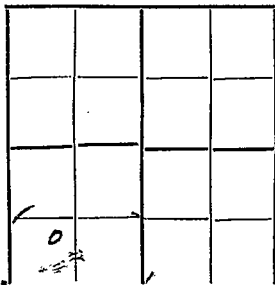

Location

Rig up

Drilling and Remarks:

Chg Ownership

RECORD

Cased in., ft.

Sand

Gas

Oil

Total Depth

PRODUCTION

1st 24 hrs. Nat.

1st 24 hrs. after shot

Gas Cu. Ft.

Dry Hole

Abandoned

Date

JUL 13 1932 CHAS. L. SHERWOOD

192

Scout

McPherson

43 KANSAS

Map No. _____ Sec. 2 Twp. 20 R. 3^W

Well No. 1 Bridgens

Garden City Co. _____ Company

Contractor

COMPLETED

SECTION PLAT

Ft. from N. Line

990 Ft. from S. Line

Ft. from E. Line

990 Ft. from W. Line

Location _____

Rig up _____

Drilling and Remarks:

Flow 225 Bbl
24 Hours.

RECORD

Cased _____ in., _____ ft.
 Sand 2973-3037
 Gas _____
 Oil _____
 Total Depth 3037

PRODUCTION

1st 24 hrs. Nat. _____
 1st 24 hrs. after shot _____
 Gas _____ Cu. Ft.
 Dry Hole _____
 Abandoned _____

Date

SEP 1 4 1932 CHAS. L. SHERWOOD

192 _____ Scout