


SECTION 2 TOWNSHIP 20 S RANGE 2 W

WELL NO. # 1 Koehn

COMPANY Geo. Hess

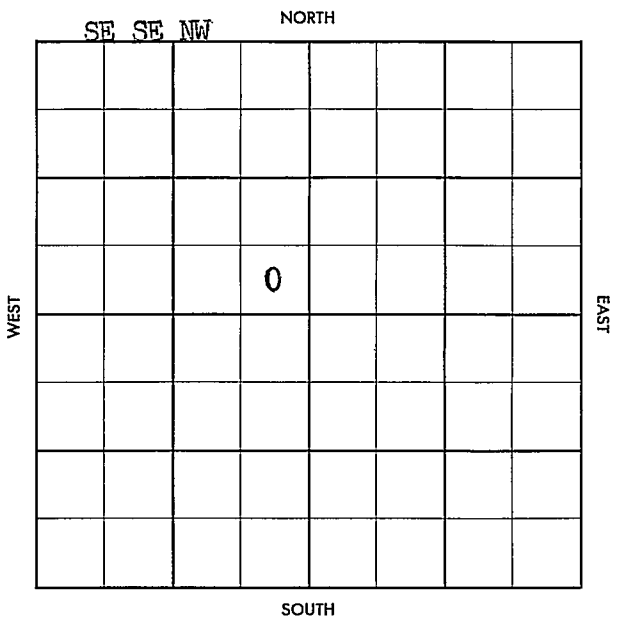

County McPherson

Elev. 1535 DF

Sec. 2 Twp. 20

Res. 2W

Company Geo. Hess

Farm Name Koehn

No. 7

| TOPS   | DEPTH | LOG | DATUM | Loc. in Sec.  |
|--------|-------|-----|-------|---------------|
| Anh.   |       |     |       | SE SE NW      |
| TP.    |       |     |       |               |
| H.     |       |     |       |               |
| Tr.    |       |     |       |               |
| Dg.    |       |     |       |               |
| BL.    |       |     |       |               |
| L.     |       |     |       | Geol.         |
| K.C.   | 2292  |     |       | Contr.        |
| B.K.C. |       |     |       | Mallard Tools |
| Ce.    |       |     |       | Pool          |
| C.     |       |     |       | Ritz Canton   |
| M.     |       |     |       |               |
| M.     |       |     |       |               |
| K.     |       |     |       |               |
| Mz.    |       |     |       |               |
| Mq.    |       |     |       |               |
| V.     |       |     |       |               |
| S.     |       |     |       |               |
| S.     |       |     |       |               |
| A.     |       |     |       |               |
| R.     |       |     |       |               |
| PE.    |       |     |       |               |
| G.     |       |     |       |               |
| TD.    |       |     |       |               |

Date Comm. 8/21/57

8" @ 167 w/125 Drlg 2688

Co-

Use:

5

**56C.**

1.

३.

FORM 513 SUNRAY

County McPherson Elev. 1535 DF  
 Sec. 2 Twp. 20 Rge. 2W  
 Company Geo. Hess  
 FarmName Koehn No. 1

| TOPS   | DEPTH | LOG | DATUM | Loc. in Sec.  |
|--------|-------|-----|-------|---------------|
| Anh.   |       |     |       | SE SE NW      |
| Tr.    |       |     |       |               |
| H.     |       |     |       |               |
| Tr.    |       |     |       |               |
| Dg.    |       |     |       |               |
| Bl.    |       |     |       |               |
| L.     |       |     |       |               |
| K.C.   | 2292  |     |       | Geol.         |
| B.K.C. |       |     |       | Contr.        |
| Ce.    |       |     |       | Mallard Tools |
| C.     | 2920  |     |       | Pool          |
| M.     |       |     |       | Ritz Canton   |
| M.     |       |     |       |               |
| K.     |       |     |       |               |
| Mz.    |       |     |       |               |
| Mo.    |       |     |       |               |
| V.     |       |     |       |               |
| S.     |       |     |       |               |
| S.     |       |     |       |               |
| A.     |       |     |       |               |
| R.     |       |     |       |               |
| PE.    |       |     |       |               |
| G.     |       |     |       |               |
| T.D.   | 2945  |     |       | SEP 18 57     |

Date Comm. 8/21/57

8" @ 167 w/125 Drlg 2688 SEP 4 57 5' 2924

WOC SEP 11 57 SEP 18 57 CD DD 2948

FU Flowed POP P 80 Bpd

mouth

25 BOPD mouth