



M. O. Rherson

**KANSAS**

Map No. \_\_\_\_\_ Sec. 2 Twp. 20 R. 30


Well No. 2 Bridgens Farm \_\_\_\_\_  
Turnman Oil Company \_\_\_\_\_

\_\_\_\_\_ Ft. from N. Line

990' Ft. from S. Line

990' Ft. from E. Line

\_\_\_\_\_ Ft. from W. Line

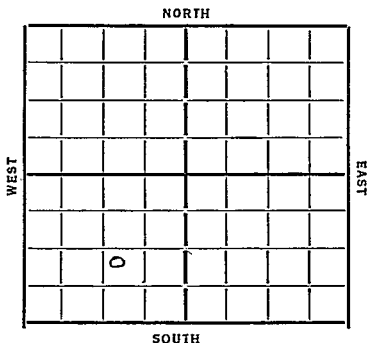

Date 1/23/34

**REPORT**

1/10 Material  
1/17 Rig  
1/24 slug 1623  
1/31 " 2566  
2/7 8" 2990 TD 2991 RUST  
2/14 Dry cement  
2/23 Chrt 2983 8" 2990 Pay  
 3015-23 TD 3042 flow  
 40 Bbls, 8 hrs.  
2/28 Chrt 2983 9D 3042 flow  
 248 Bbls.

**COMPLETED**

Map No. 43 Sec. 2 Twp. 20 R. 3W

Well No. 2 - Bridgens

Turnman Oil Company

Contractor

**FIRST REPORTS**

**SECTION PLAT**

Ft. from N. Line

990 Ft. from S. Line

990 Ft. from E. Line

Ft. from W. Line


Location

Rig up

Drilling and Remarks:

*Material*

**RECORD**

Cased \_\_\_\_\_ in., \_\_\_\_\_ ft.

Sand \_\_\_\_\_

Gas \_\_\_\_\_

Oil \_\_\_\_\_

Total Depth \_\_\_\_\_

**PRODUCTION**

1st 24 hrs. Nat. \_\_\_\_\_

1st 24 hrs. after shot \_\_\_\_\_

Gas \_\_\_\_\_ Cu. Ft.

Dry Hole \_\_\_\_\_

Abandoned \_\_\_\_\_

Date

1-10-34 1924 O. Manschuck Scout

Map No. 43 Sec. 2 Twp. 20 R. 3N

Well No. 2 - Bridgens

Turnman Oil Company

Contractor

SECTION PLAT

	0		

Ft. from N. Line

990 Ft. from S. Line

990 Ft. from E. Line

Ft. from W. Line

**COMPLETED**

Location

Rig up

Drilling and Remarks:

*flow*  
*248 bbls*

RECORD

Cased \_\_\_\_\_ in., \_\_\_\_\_ ft.

Sand Chat 2983

Gas \_\_\_\_\_

Oil \_\_\_\_\_

Total Depth 3047

PRODUCTION

1st 24 hrs. Nat. \_\_\_\_\_

1st 24 hrs. after shot \_\_\_\_\_

Gas \_\_\_\_\_ Cu. Ft.

Dry Hole \_\_\_\_\_

Abandoned \_\_\_\_\_

Date

2-28-34 192 O. Mamm... Sec 19