


SECTION 2 TOWNSHIP 20 RANGE 3W

WELL NO. #1 Gray

COMPANY Jess Cling

NORTH

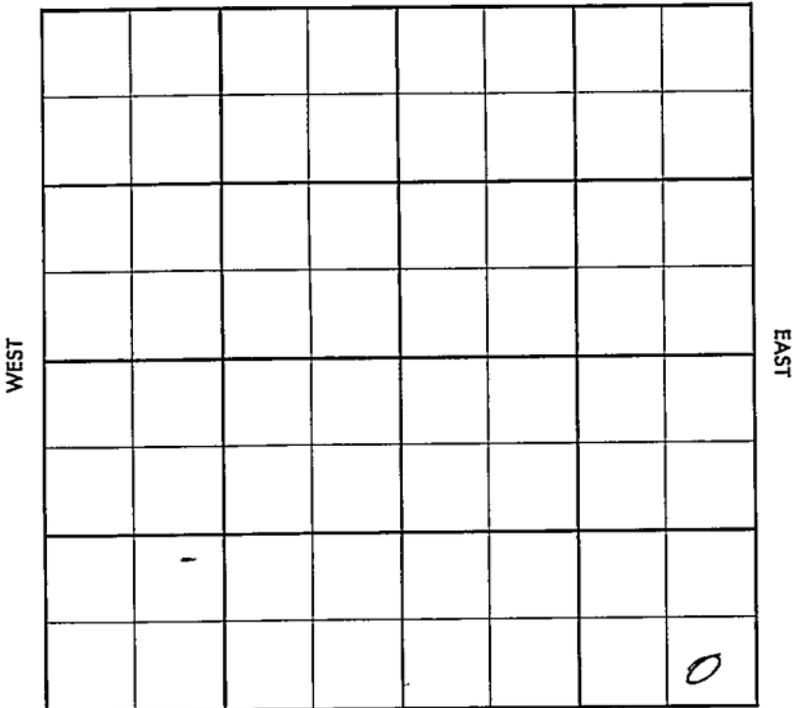

SOUTH

McPherson

KANSAS

SEC. 2	TWP. 20	R. 3W
-----------	------------	----------

WELL NO. #1 Gray FARM

COMPANY Jess Cling

CONTRACTOR

_____ Ft. from N. Line

_____ Ft. from S. Line

_____ Ft. from E. Line

_____ Ft. from W. Line

SE SE SE

1956	ELEVATION 1506' Gr.	REPORT
------	------------------------	--------

5-16 Comm. 5-5-56
8 5/8" @ 180 w/135
Drlg. 1900

5-29 D&A
L. 2400', M. 3066', K. 3258', Mq. 3463'
S. 3565'.
TD 3601'

ABANDONED

County McPherson Elev. _____
 Sec. 2 Twp. 20 Rgs. 3W
 Company Jess Cling
 FarmName Gray No. 1

TOPS	DEPTH	LOG	DATUM
Anh.			
TP.			
H.			
Tr.			
Dg.			
Bl.			
L.			
K.C.			
B.K.C.			
Ce.			
C.			
M.			
M.			
K.			
Mz.			
Mo.			
V.			
S.			
S.			
A.			
R.			
PE.			
G.			
T.D.			

Loc. in Sec. SE SE SE

Geol. _____

Contr. _____

Pool _____

MAY 15 1956
 FIRST REPORT

Date Comm. 5-5-56
8 5/8" @ 180/135 dirg. 1900

AM 5 S 1956

Co.

Lse.

No.

Sec.

T.

R.

County McPherson Elev. 1506 Gr.
 Sec. 2 Twp. 20 Rge. 3W
 Company Jess Cling
 Farm Name Gray No. 1

Co.

TOPS	DEPTH	LOG	DATUM
Anh.			
TP.			
H.			
Tr.			
Dg.			
Bl.			
L.	2400		894
K.C.			
B.K.C.			
Ce.			
C.	3066		1560
M.			
M.	3258		1752
K.			
Mz.	3463		1957
Mo.	3521		2015
V.	3565		2059
S.			
S.			
A.			
R.			
PE.			
G.			
TD.	3601		

Loc. in Sec. SE SE SE

Geol. _____
 Contr. _____

Pool _____

ABANDONED

Loc.

No.

Sec.

T.

R.

Date Comm. 5-5-56 MAY 29 1956

8 5/8" @ 180/135 d r l r . 1900 MAY 23 '56

ID 2961 MAY 29 '56

DEA