

KANSAS McPherson

Section 2 Township 20 Range 3WWell No. 8 JohnsonCompany Shell

Johnson Pool

NORTH

		0					

WEST

EAST

SOUTH

Sec. 2 Twp. 20 R. 3-W

Well No. #8 Johnson Farm

Shell Company


Johnson
Ft. from N. Line

990 Ft. from S. Line

990 Ft. from E. Line

Ft. from W. Line

NW SE NW

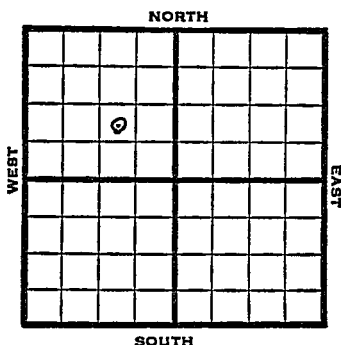

1948	Elev. 3020' REPORT
10/6	Location
10/13	8" @ 221' Drlg. 1105'
10/19	"
10/26	Mississippi 2958' TD 2961 4" @ 2959'
11/3	2992 swb 2½ bbls oil PH 2 hrs. Drlg 2995'
11/10	1000 acid S wb 7½ bbls oil / 10 W 7 hrs. TD 3020'
11/17	Miss 2958' 4" @ 2959' 2000 acid Pump 13 oil & 12 W Pot. Gr. 38 TD 3020'

COMPLETED

Map No. _____ Sec. 2 Twp. 20 R. 3W

Well No. 8 Johnson

Shell Company

FIRST REPORT Contractor

NW SE NW

SECTION PLAT

	D		

_____ Ft. from N. Line

990 Ft. from S. Line

990 Ft. from E. Line

_____ Ft. from W. Line

McPherson County

Location X

Rig up _____

Drilling and Remarks:

RECORD

Cased _____ in., _____ ft.

Sand _____

Gas _____

Oil _____

Total Depth _____

PRODUCTION

1st 24 hrs. Nat. _____

1st 24 hrs. after shot _____

Gas _____ Cu. Ft.

Dry Hole _____

Abandoned _____

Date

OCT 6 1948 19

S. J. LEWIS Scout

Map No. 43 Sec. 2 Twp. 20 R. 3W

Well No. 8 Johnson

Shell Company

COMPLETE

Contractor

NW SE NW


E1. 1496
SECTION PLAT

 Ft. from N. Line

990 Ft. from S. Line

990 Ft. from E. Line

 Ft. from W. Line

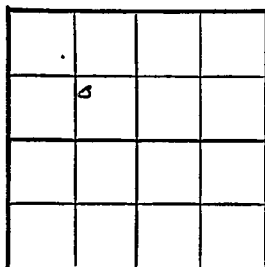

McPherson County

Location

Rig up

Drilling and Remarks:

Mar 2958
1102259
2000 cu. ft.
Pump 130 ft + 12 ft
OST
38 3/4 in

RECORD

Cased in., ft.

Sand

Gas

Oil

Total Depth 3020

PRODUCTION

1st 24 hrs. Nat.

1st 24 hrs. after shot

Gas Cu. Ft.

Dry Hole

Abandoned

Date

NOV 17 1948 19 S. J. LEWIS Scout