

KANSAS


McPherson

Section 2 Township 20 Range 3W

Well No. 1 Osborne "B"

Company H.J. Uhl et al

Johnson
NORTH

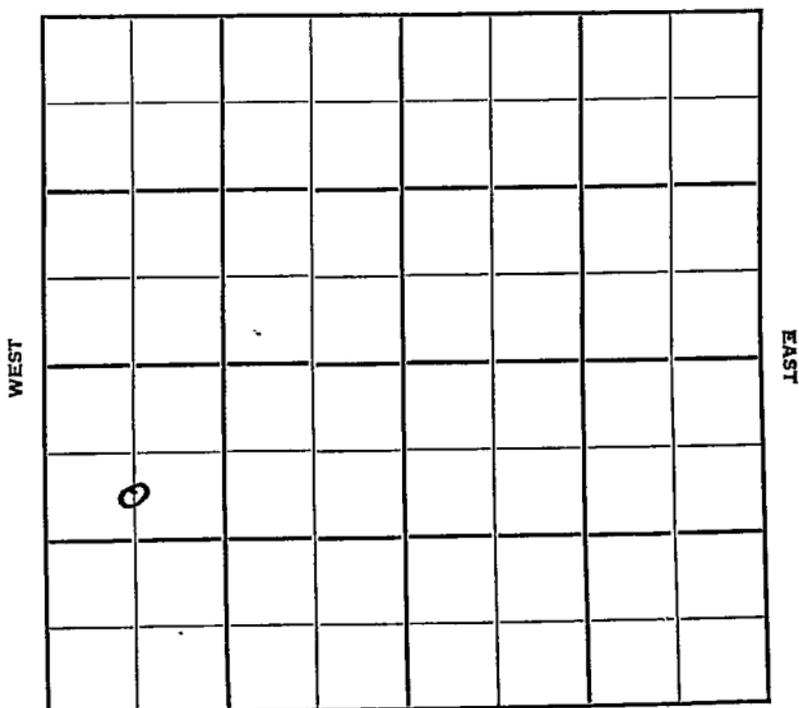

SOUTH

Sec. 2 Twp. 20 R. 3W

Well No. #1 Osborne "B" Farm.

H. J. Uhl et al

Company

Johnson Pool (Uhl, Cont.)


990' Ft. from N. Line

_____ Ft. from S. Line

_____ Ft. from E. Line

660' Ft. from W. Line

C S L NW SW

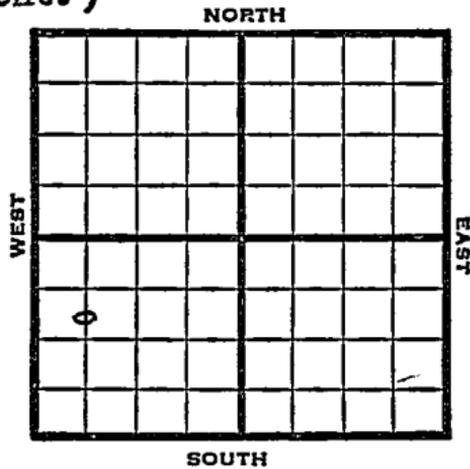

1949	Elev 1496' REPORT
7/6	RUR
7/12	8" @ 220'
	Drlg 1213
7/20	Drlg 2765'
7/27	M ₁ ss 2992-95'
	TD 2995'
	4" @ 2993'
8/3	Drlg 2998'
8/10	TD 3012
	600' oil
8/17	TD 3016'
	Swb 6 bbls oil in 4 hrs.
8/24	500 acid
8/31	Swb 20 bbls oil 4 hrs.
9/7	2000 acid
9/14	"
9/21	TD 3029'
	Miss 2992'
	4" @ 2993'
	2500 acid
	Pump 20 oil Pot
	38° Gr.
	Comp
	COMPLETED

Kansas

Map No. _____ Sec. 2 Twp. 20 R. 3WWell No. 1 Osborne "B"

_____ H. J. Uhl et al. _____ Company

_____ Uhl _____ Contractor

C S L NW SW

FIRST SECTION REPORT
SECTION PLAT990 Ft. from N. Line

_____ Ft. from S. Line

_____ Ft. from E. Line

660 Ft. from W. Line

McPherson County

Location _____

Rig up _____

Drilling and Remarks: _____

R U R

RECORD

Cased _____ in., _____ ft.

Sand _____

Gas _____

Oil _____

Total Depth _____

PRODUCTION

1st 24 hrs. Nat. _____

1st 24 hrs. after shot _____

Gas _____ Cu. Ft.

Dry Hole _____

Abandoned _____

Date

JUL 6 1949 19S. J. LEWIS Scout

Kansas

Map No. K43 Sec. 2 Twp. 20 R. 3W

Well No. I Osborne "B"

H. J. Unl et al.

Company

COMPLETE

Contractor

C S L NW SW

E 11496
SECTION PLAT

990 Ft. from N. Line

_____ Ft. from S. Line

_____ Ft. from E. Line

660 Ft. from W. Line

McP. erson County

Location _____

Rig up _____

Drilling and Remarks:

Miss 2972.

4" @ 2978

25000 cu ft

Pump 2000 ft

38° S

RECORD

Cased _____ in., _____ ft.

Sand _____

Gas _____

Oil _____

Total Depth 3027

PRODUCTION

1st 24 hrs. Nat. _____

1st 24 hrs. after shot _____

Gas _____ Cu. Ft.

Dry Hole _____

Abandoned _____

Date

SEP 21 1949 19

S. J. LEWIS Scout