

KANSAS

Map No. _____ Sec. 2 Twp. 20 R. 3W

Well No. 1 Tepton Farm _____


Continental Company

_____ Ft. from N. Line

1004 Ft. from S. Line

_____ Ft. from E. Line

330 Ft. from W. Line

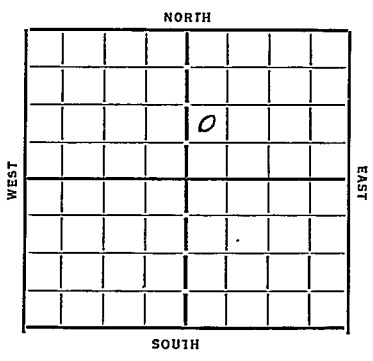

Date 7/9/33

REPORT

- 7/5 Location
- 7/12 Rig
- 7/19 15" - 246 Drly 935'
- 7/26 drly 2325'
- 8/2 " 2684'
- 8/9 Top Chat 3015' T.D. 3020 Cont 8'
- 8/17 —
- 8/23 400' oil 3048 T.D. 3053 - 2800' oil
- 8/30 swab 110 bbls 24-hr
- 9/6 Chat 3015
T.D. 3053 100. bbls

COMPLETED

KANSAS

Map No. _____ Sec. 2 Twp. 20 R. 3WWell No. 43 #1 - TiptonContinental Company

Contractor _____

SECTION PLAT

		o	

_____ Ft. from N. Line

1004 Ft. from S. Line

_____ Ft. from E. Line

330 Ft. from W. Line

FIRST REPORTS

Location V

Rig up _____

Drilling and Remarks:

RECORD

Cased _____ in., _____ ft.

Sand _____

Gas _____

Oil _____

Total Depth _____

PRODUCTION

1st 24 hrs. Nat. _____

1st 24 hrs. after shot _____

Gas _____ Cu. Ft.

Dry Hole _____

Abandoned _____

Date

7/5/33 1933Carl Mannschreck Sec'y

Mofferson

Map No. 43 Sec. 2 Twp. 20 R. 3N

Well No. 1 *Tipton*

Continental Company

Contractor

SECTION PLAT

		0	

Ft. from N. Line

1004 Ft. from S. Line

Ft. from E. Line

330 Ft. from W. Line

Location

Rig up

Drilling and Remarks:

100 bbls

RECORD

Cased in, ft.

Sand *Chat 3015*

Gas

Oil

Total Depth 3053

PRODUCTION

1st 24 hrs. Nat.

1st 24 hrs. after shot

Gas Cu. Ft.

Dry Hole

Abandoned

Date

9/6/33 *O. Manner* Scout