


10-20-20W

WELL LOG BUREAU—KANSAS GEOLOGICAL SOCIETY
508 East Murdock, Wichita, Kansas

Company- NATIONAL COOPERATIVE REFINERY ASSN.
Farm- Robinson No. 1

SEC. 10 T. 20 R. 20W
C SE NE

Total Depth. 4301'
Comm. 6-30-64 Comp. 7-8-64
Shot or Treated.
Contractor. NCRA
Issued. 12-19-64

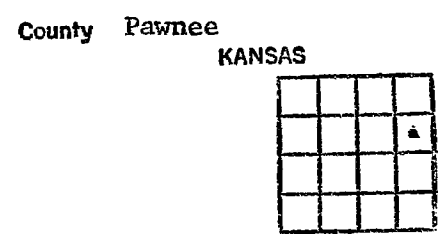

Elevation. 2214' KB

Production. 53½ BOPD / 25% Wtr

3 5/8" 505.6' cem w/ 300 sx
5½" 4300' cem w/ 100 sx

Figures indicate Bottom of Formations.

surface	465
shale	508
salt, shale & sand	1400
shale	2245
shale & lime	2415
lime	2600
lime & shale	3196
limy shale	3414
lime w/ chalk	3679
lime	4150
lime & shale	4250
shale, sand & chert	4301
Total Depth	

TOPS:SCOUT	
Anhydrite (Smp)	1357
Heebner	3663
Lansing	3710
Base Kansas City	4060
Cherokee	4172
Cherokee sand	4241
Mississippi	4265