

KANSAS

Form 51—5M—7-39—Palace

McPherson

Section 20 Township 20 Range 5-W

Well No. #2 Briggs


Company W. H. Moulton et al

Bornholdt Pool

NORTH

WEST

EAST

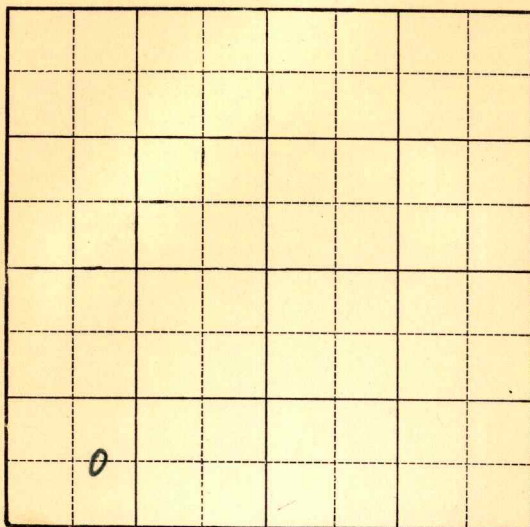


SOUTH

(Bornholdt)

990 Ft. from W. Line

Elev. 1557

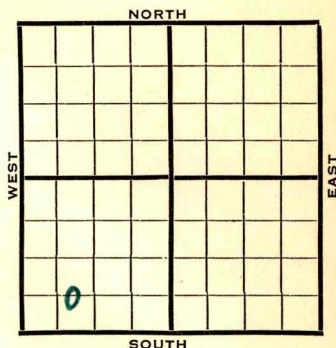[illegible]

McPherson

KANSAS

Map No. 48 Sec. 20 Twp. 20 R. 5WWell No. 2 BriggsW. H. Moulton et al Company

Contractor

FIRST REPORT

C E $\frac{1}{2}$ SW SW

Ft. from N. Line

660 Ft. from S. Line

Ft. from E. Line

990 Ft. from W. Line

BORNHOLDT POOL

SECTION PLAT

o			

Location X

Rig up

Drilling and Remarks:

RECORD

Cased _____ in., _____ ft.

Sand _____

Gas _____

Oil _____

Total Depth _____

PRODUCTION

1st 24 hrs. Nat. _____

1st 24 hrs. after shot _____

Gas _____ Cu. Ft.

Dry Hole _____

Abandoned _____

Date

MAY 1 1940

19

S. J. LEWIS

Scout

Map No. 48 Sec. 20 Twp. 20 R. 5WWell No. 2 BriggsW. H. Moulton etal Company

Contractor

COMPLETED

C $E\frac{1}{2}$ SW SW Ft. from N. Line660 Ft. from S. Line Ft. from E. Line990 Ft. from W. Line

BORNHOLDT POOL

SECTION PLAT

Location Rig up

Drilling and Remarks:

*Cha 83352**5" C 3352**Born & P 5283**M 8000*

RECORD

Cased in., ft.Sand Gas Oil Total Depth 3321

PRODUCTION

1st 24 hrs. Nat. 1st 24 hrs. after shot Gas Cu. Ft.Dry Hole Abandoned

Date

JUN 26 1940 19

S. J. LEWIS

Scout