


Section 20 Township 20 Range 5W

Well No. #4 Briggs

Company W. L. Molton
L. Molton ~~W. L. Hartman~~

Bornholdt Pool
NORTH

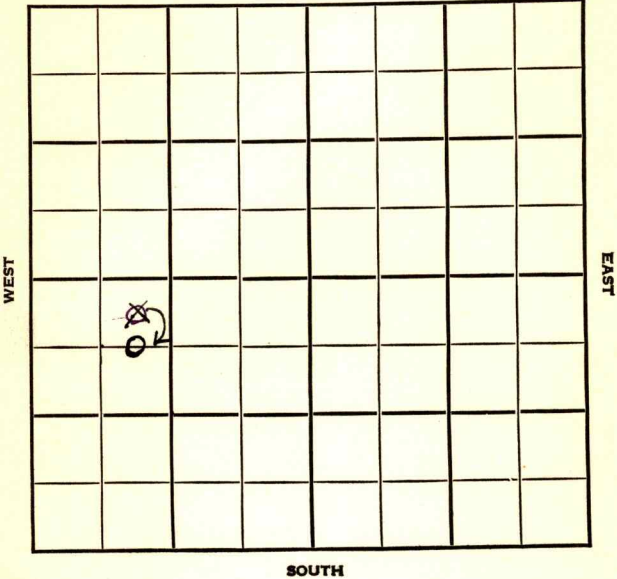

Sec. 20 Twp. 20 R. 5W

Well No. #4 Briggs Farm

W. L. Molton Company

Bornholdt

660'
330 Ft. from N. Line


_____ Ft. from S. Line

_____ Ft. from E. Line

990 Ft. from W. Line

CEL NW SW

~~NE NW SW~~

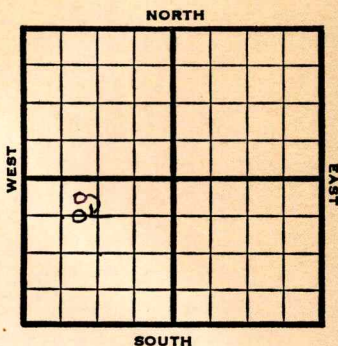

1948

Elev. 1557' REPORT

4/14 Drlg. 1570'

4/21 **Mississippi 3359'**

TD 3362'

5" @ 3359'

RUST

4/28 TD 3367' Water.

5/5 **Miss 3359'**

5" @ 3359'

Pump 50 oil Pot.

Gr. 39°

TD 3367'

COMPLETED

Map No. 48 Sec. 20 Twp. 20 R. 5W

Well No. 4 Briggs

W. L. Molton Company

COMPLETE

Contractor

C E L N W S W

E. L. 1557
SECTION PLAT

660 Ft. from N. Line

_____ Ft. from S. Line

_____ Ft. from E. Line

990 Ft. from W. Line

McPherson County

Location _____

Rig up _____

Drilling and Remarks:

*Mis 8309
5" casing
Pump 50 x 1 Rod*

390 ft

RECORD

Cased _____ in., _____ ft.

Sand _____

Gas _____

Oil

Total Depth 3867

PRODUCTION

1st 24 hrs. Nat. _____

1st 24 hrs. after shot _____

Gas _____ Cu. Ft.

Dry Hole _____

Abandoned _____

Date

MAY 5 1948 19

S. J. LEWIS Scout

Map No. 48 Sec. 20 Twp. 20 R. 5W

Well No. 4 Briggs

W. L. Hartman Company

CORRECTION Contractor

C E L NW SW

SECTION PLAT

660 Ft. from N. Line

 Ft. from S. Line

 Ft. from E. Line

990 Ft. from W. Line

McPherson County

Location

Rig up

Drilling and Remarks:

Reported

NE NW SW

RECORD

Cased in., ft.

Sand

Gas

Oil

Total Depth

PRODUCTION

1st 24 hrs. Nat.

1st 24 hrs. after shot

Gas Cu. Ft.

Dry Hole

Abandoned

Date

APR 21 1948

19

S. J. LEWIS

Scout

Map No. _____ Sec. 20 Twp. 20 R. 5W

Well No. 4 Briggs

W. L. Molton Company

FIRST REPORT

Contractor

NE NW SW


SECTION PLAT

330 Ft. from N. Line

_____ Ft. from S. Line

_____ Ft. from E. Line

990 Ft. from W. Line

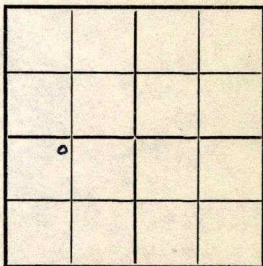

McPherson County

Location _____

Rig up _____

Drilling and Remarks:

drlg. 1570

RECORD

Cased _____ in., _____ ft.

Sand _____

Gas _____

Oil _____

Total Depth _____

PRODUCTION

1st 24 hrs. Nat. _____

1st 24 hrs. after shot _____

Gas _____ Cu. Ft.

Dry Hole _____

Abandoned _____

Date

APR 14 1948

19

S. J. LEWIS

Scout