

# Office of County Engineer, Ness County


GEORGE PROSE, County Engineer

NESS CITY, KANSAS

I - 22 - 64

O'Brien A #1

C - SE - SW - 6 - 20 - 21 - Ness County, Kansas.

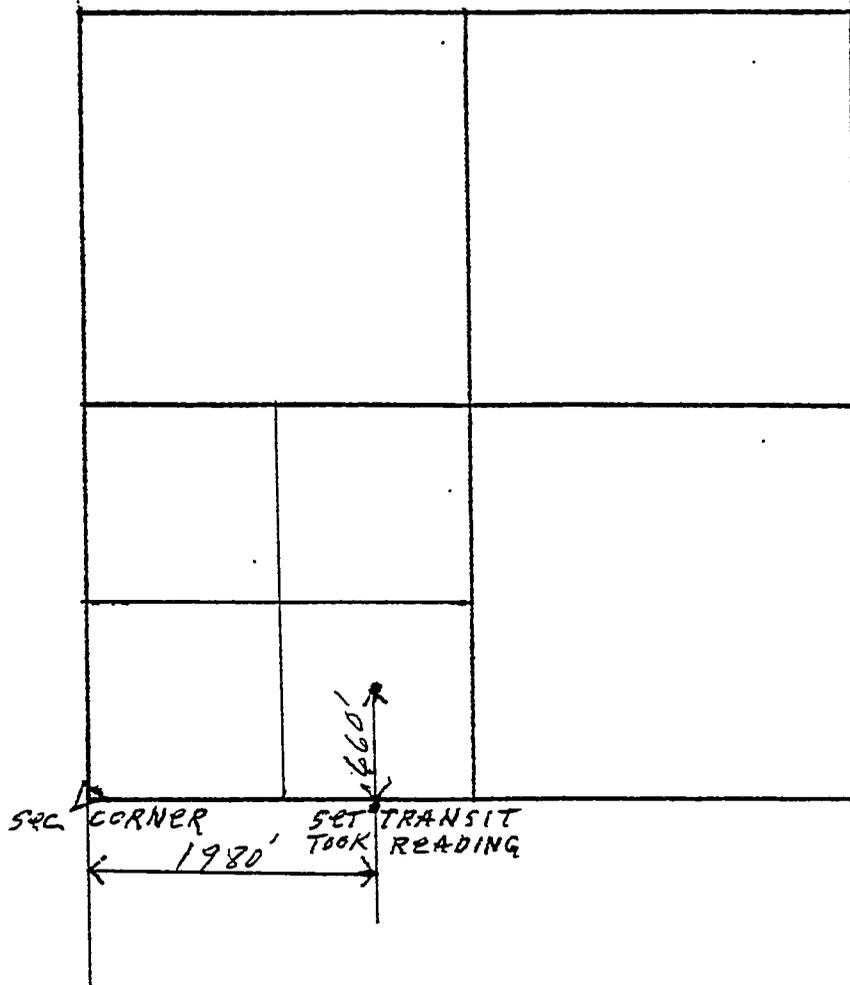

Surveyed and Plotted by  
 George W. Prose, County Engineer  
 Ness County, Kansas

*George W. Prose*  
 George W. Prose