


Section 22 Township 20 Range 3W

Well No. 1 Beam

Company Brinrich Drlg.

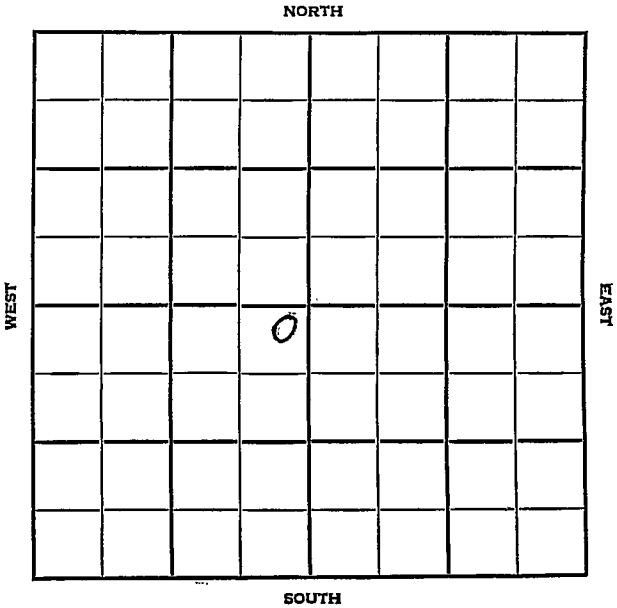

County McPherson Elev. _____
 Sec. 22 Twp. 20 Rge. 3W
 Company Brinrich Drlg.
 Farm Name Beam No. 1

TOPS	DEPTH	LOG	DATUM
Anh.			
Tp.			
H.			
Tr.			
Dg.			
Bl.			
L.			
K.C.			
B.K.C.			
Ce.			
C.			
M.			
M.			
K.			
Mz.			
Me.			
V.			
S.			
S.			
A			
R.			
Pe.			
G.			
T.D.			

Loc. in Sec. NE NE SW

Geol. _____

Contr. _____

Co. tools _____

Pool _____

Wildcat

FIRST REPORT
 0
 JUL 6 '55

Date Comm. _____

M I R

Co.
Lse.
No.
Sec.
T.
R.

County Mcpherson Elev. 1487
 Sec. 22 Twp. 20 Rge. 3W
 Company Brinrich Drlg.
 FarmName Beam No. 1

TOPS	DEPTH	LOG	DATUM
Anb.			
Tr.			
H.			
Tr.			
B. Dg. <u>sd</u>	<u>2330</u>		<u>843</u>
Bl.	<u>2355</u>		<u>868</u>
L.	<u>2420</u>		<u>933</u>
K.C.			
B.K.C.			
Ce.			
C.			
M.	<u>3076</u>		<u>1589</u>
M.			
K.	<u>3266</u>		<u>1779</u>
Mz.			
Mq.	<u>3462</u>		<u>1975</u>
V.	<u>3527</u>		<u>2040</u>
S. <u>sdly dol</u>	<u>3564</u>		<u>2077</u>
S. <u>green ch.</u>	<u>3568</u>		<u>2081</u>
A			
R.			
PE.			
G.			
TD.	<u>3576</u>		

Loc. in Sec. NE NE SW
 Geol. _____
 Contr. _____
 Co. tools _____
 Pool Wildcat

ABANDONED

Date Comm. 7-6-55 AUG 3 1955
8 5/8" @ 238/150 DST 3078-3100
open 1 hr. Rec. 145' gassy wtry mud
735# TD 3576

D & A

Co.
Lse.
No.
Sec.
T.
R.