

Rice


FORM 51

KANSAS

Section 22 Township 20 Range 6W

Well No. #1 Fry

Company Sterling Drlg. & Davis-Childs

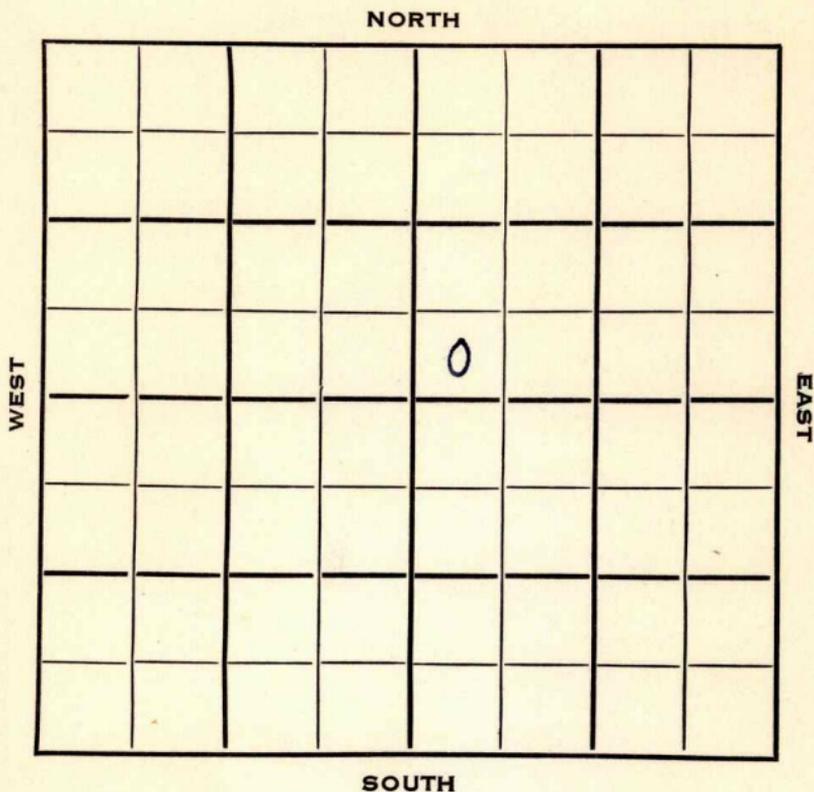

Rice

KANSAS

SEC.	TWP.	R.
22	20	6W

WELL NO.

#1 Fry

FARM

COMPANY

Sterling Drlg. & Davis-Childs

CONTRACTOR

Sterling

N. Welch Pool


NORTH

_____ Ft. from N. Line

330 _____ Ft. from S. Line

_____ Ft. from E. Line

330 _____ Ft. from W. Line

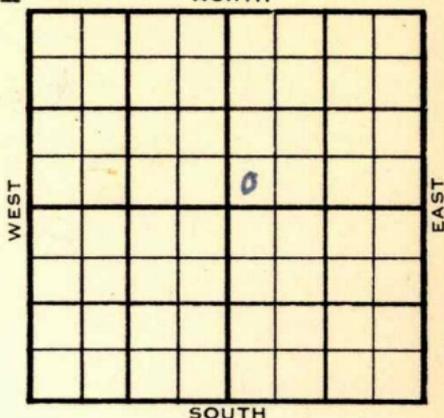

SW SW NE

	ELEVATION	REPORT
1953	1589'	
10/7	Spud 10-1-53 8" @ 126' Drlg 2350'	
10/14	KC 2767' Cong 3313' Miss 3323' RTD 3328' 5" @ 3325'	
10/21	NR	
10/28	"	
11/4	"	
11/11	NR	
11/18	Spud 10-1-53 D&A TD 3375' 8" @ 126' KC 2767', Cong 3313', Miss 3323' TD 3328' 5" @ 3325' DD 3340', FU 60' fluid 8 hrs., 85% wtr., DD 3375' PB 16/3313-17, 16/3309-13, 24/3317-21, FU 90' oil, 90' wtr. D&A	

ABANDONED

County Rice State Kansas

Sec. 22 (Blk. 20) (Sur. 6W) (Twp.) (Rge.) Map No.

Operator Sterling Drlg. & Davis-Childs

Well No. 1 Farm Fry

Elev. _____ Location SW SW NE

FIRST REPORT

330 Ft. From S Line NE

330 Ft. From W Line Quarter

1st. Report OCT 7 1953

Completion _____

Remarks Sterling Drlg. - Contr.

Spudding Date 10-1-53

Drlg. Data N. Welch Pool

8" @ 126 drlg. 2350

