

Section 22 Township 20 Range 6 WWell No. # 1 White "B"Company ~~Plains Exploration & Sterling Drilg.~~

NORTH

				0			

WEST

EAST

SOUTH

Rice

KANSAS

Sec. 22 Twp. 20 R. 6W

Well No. #1 White "B" Farm

Plains Exploration & Sterling Drlg. Company

Sterling Drlg. Contractor

Welch Pool


330 Ft. from N. Line

 Ft. from S. Line

 Ft. from E. Line

330 Ft. from W. Line

NW NW SE

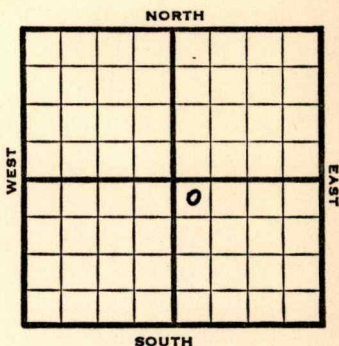

1953 **Elev. 1591'** REPORT

5/20 Surface Set

5/28 N.R.

6/3 8" @ 130
Drlg. 1418'

6/10 **Lans 2770 Cong 3317 Miss 3327**
RTD 3335 5" @ 3334

6/24 N.R.

7/8 Spud 5-29-53

Oil Well

TD 3381

8" @ 130

Lans 2770, Cong 3317, Miss 3327

TD 3335

5" @ 3334

DD 3344, 2 gopd, DD 3381, 15 gwph


SP 3010, 16/3002-06, FU 2070' oil 3

hrs., S/2½ boph 5 hrs., P/38 bo 16 hrs

Comp. 35 bopd

COMPLETED

County Rice State Kansas
 Sec. 22 (Blk. 20 (Sur. 6W Map No.
 (Twp.) (Rge.)
 Operator Plains Exploration & Sterling Drlg.
 Well No. 1 Farm White "B"
 Elev. _____ Location NW NW SE

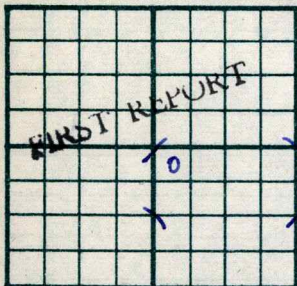

330 Ft. From N Line SE
330 Ft. From W Line Quarter
 1st. Report MAY 20 1953

Completion _____

Remarks _____

Sterling Drlg. - Contr.


Spudding Date _____

Drlg. Data _____

Welch Pool

surface set

County Rice State Kansas
 Sec. 22 (Blk.) 20 (Sur.) 6W Map No.
 Operator Plains Exploration & Sterling Drlg.
 Well No. 1 Farm White "B"
 Elev. 1591 Location NW NW SE

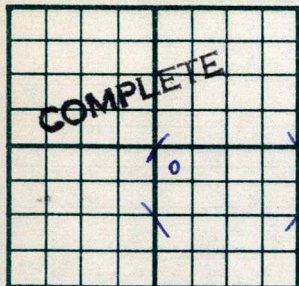

330 Ft. From N Line SE
330 Ft. From W Line Quarter
 1st. Report
 Completion JUL 8 1953
 Remarks Welch Pool
Sterling Drlg. - Contr.
 Spudding Date 5-29-53

Drig. Data Oil well TD 3381
8" @ 130 Lans. 2770 Cong. 3317
Miss. 3327 TD 3335 5" @ 3334 DD 3344
2 gopd DD 3381 15 gwph SP 3010
16/ 3002-06 FU 2070' oil 3 hr.
S/ 2½ boph 5 hr. P/ 38 bo 16 hr.
Comp. 35 bopd

J. G. McGEHEE