


Section 22 Township 20 Range 8W

Well No. #1 Fee \_\_\_\_\_

Company H. A. Hutchins

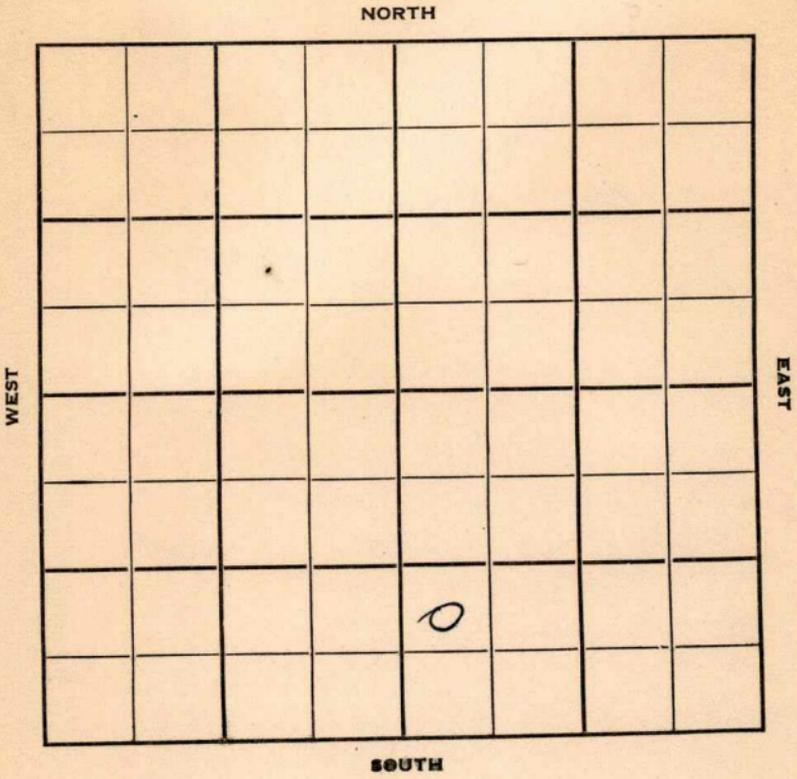

Rice  
20

KANSAS

8W

Sec. 22 Twp. \_\_\_\_\_ R. \_\_\_\_\_

Well No. #1 Fee \_\_\_\_\_ Farm \_\_\_\_\_

H. A. Hutchins Company \_\_\_\_\_

Tom Allen Contractor \_\_\_\_\_  
Wildcat


\_\_\_\_\_ Ft. from N. Line

990' Ft. from S. Line

\_\_\_\_\_ Ft. from E. Line

330' Ft. from W. Line

NW SW SE

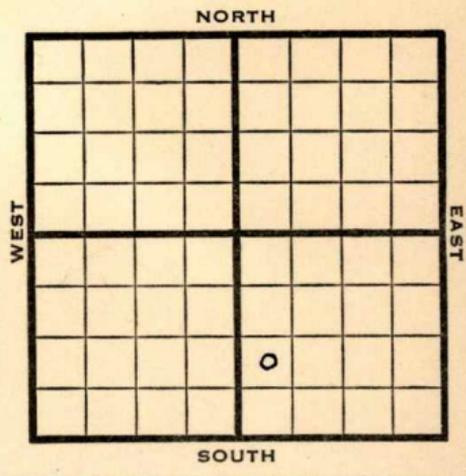

1950 **Elev 1651** REPORT

8/30

MIM

9/27

Spud 9-2-50

8" @ 189

Br Lime 2870 Lans 2897

Cong 3306 Kinderhook 3311

Misener 3437

5" @ 3435

TD 3445

HFW

D&A

**ABANDONED**


County Rice State Kansas

Sec. 22 (Blk. Twp.) 20 (Sur. Rge.) 8W Map No.

Operator H. A. Hutchins

Well No. 1 Farm Fee

Elev. \_\_\_\_\_ Location NW SW SE

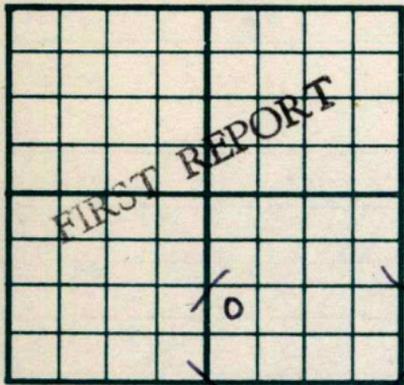

990 Ft. From S Line SE

330 Ft. From W Line Quarter

1st. Report AUG 30 1950

Completion \_\_\_\_\_

Remarks \_\_\_\_\_

Spudding Date \_\_\_\_\_

Drlg. Data Wildcat

M I M

J. E. TYRA

County Rice State Kansas

Sec. 22 (Blk. 20 (Sur. 8W (Rge.) Map No.

Operator H. A. Hutchins

Well No. 1 Farm Fee

Elev. 1651 Location NW SW SE



990 Ft. From S Line SE

330 Ft. From W Line Quarter

1st. Report

Completion SEP 27 1950

Remarks Wildcat

Tom Allen - Contr.

Spudding Date 9-2-50

Drlg. Data D & A TD 3438

8" @ 189 Br. lime 2870 Lans. 2897

Cong. 3306 Kinderhook 3311 Misener 3437

5" @ 3435 TD 3445 HFW D & A