

Rice

KANSAS

SECTION 22 TOWNSHIP 20 RANGE 8W

WELL NO. #1 Shenkel

COMPANY Erunson Prod.

NORTH

WEST

EAST

	0						

SOUTH

Rice

KANSAS

SEC. 22	TWP. 20	R. 8W
------------	------------	----------

WELL NO. #1 Shenkel FARM

COMPANY Brunson Prod.

CONTRACTOR Co. Tools


SW Lyons

_____ Ft. from N. Line

_____ Ft. from S. Line

_____ Ft. from E. Line

_____ Ft. from W. Line

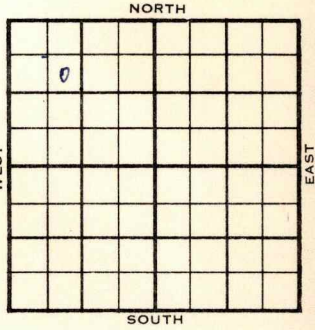

SE NW NW

1956	ELEVATION 1651 DF, 1653 RB	REPORT
------	-------------------------------	--------

3-28 Comm, 3-26-56
8" @ 181
WOC

5-9 DST 3244-71 op 1 hr. gas in 1 min.,
1500 mcfg, 792020"
4" @ 3455/100
CO 32/ 3388-96, 500 A, 200' wtr.,
scum oil.
PB 3260, 32/ 3239-47,
Comp. 3 1/2 mcfgpd
BL. 2837', L. 2875', C. 3244',
Mz. Sd. 3315', Mq. 3319, V. 3356',
S. 3388', A. 3439'.
TD 3455'

COMPLETED

1651 DF
1653 RB

County Rice Elev. 1653 RB
 Sec. 22 Twp. 20 Rge. 8W
 Company Brunson Prod.
 Farm Name Shenkel No. 1

TOPS	DEPTH	LOG	DATUM	Loc. in Sec.																														
Anh.				SE NW NW																														
Tp.																																		
H.																																		
Tr.																																		
Dg.																																		
Bl.	2837																																	
L.	2875		1224	Geol.																														
K.C.				Contr.																														
B.K.C.				Co. tools																														
Ce.				Pool																														
C.	3244		1593	SW Lyons																														
M.				<table border="1"> <tr><td></td><td></td><td></td></tr> <tr><td></td><td></td><td></td></tr> <tr><td></td><td></td><td></td></tr> <tr><td></td><td></td><td></td></tr> <tr><td></td><td></td><td></td></tr> <tr><td></td><td></td><td></td></tr> <tr><td></td><td></td><td></td></tr> <tr><td></td><td></td><td></td></tr> <tr><td></td><td></td><td></td></tr> <tr><td></td><td></td><td></td></tr> </table>																														
M.																																		
K.																																		
Mz. <i>sd.</i>	3315		1664																															
Mq.	3319		1668																															
V.	3356		1705																															
S.	3388		1737																															
S.																																		
A.	3439		1788																															
R.																																		
Pe.																																		
G.																																		
T.D.	3455																																	

Date Comm. 3-26-56 MAY 9 1956

8" @ 181 DST 3244-71 open 1 hr.

gas in 1 min., 1500 mcfg 792/20"

4" @ 3455/100 CO 32/ 3388-96

500 A 200' wtr. scum oil PB 3260

32/ 3239-47 Comp. 3 1/2 mcfgpd

COMPLETE

Co.
Lse.
No.
Sec.
T.
R.

County Rice Elev. _____
 Sec. 22 Twp. 20 Rge. 8W
 Company Brunson Prod.
 Farm Name Shenkel No. 1

TOPS	DEPTH	LOG	DATUM
Anh.			
TP.			
H.			
Tr.			
Dg.			
Bl.			
L.			
K.C.			
B.K.C.			
Ce.			
C.			
M.			
M.			
K.			
Mz.			
Ma.			
V.			
S.			
S.			
A.			
R.			
PE.			
G.			
T.D.			

Loc. in Sec. SE NW NW

Geol. _____

Contr. Co. tools

Pool SW Lyons

FIRST REPORT			
MAR 28 '56			

Date Comm. 3-26-56
8" @ 181 WOC

~~12~~

Co.
Lse.
No.
Sec.
T.
R.