

Rice

KANSAS

22

20


8W

SECTION \_\_\_\_\_ TOWNSHIP \_\_\_\_\_ RANGE \_\_\_\_\_

WELL NO. #1 Welton "C"

COMPANY Sterling Drlg

NORTH

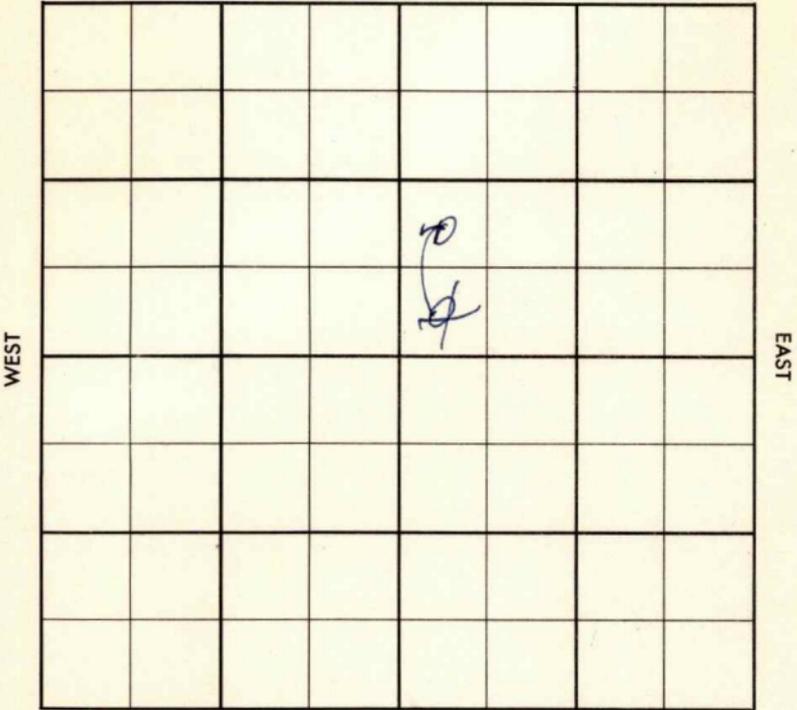

SOUTH

WEST

EAST

Rice

**KANSAS**


SEC. 22	TWP. 20	R. 8W
------------	------------	----------

WELL NO. #1 Welton "C" FARM

COMPANY Sterling Drlg.

CONTRACTOR Co. Tools

SW Lyons  
 \_\_\_\_\_ Ft. from N. Line  
 \_\_\_\_\_ Ft. from S. Line  
 \_\_\_\_\_ Ft. from E. Line  
 \_\_\_\_\_ Ft. from W. Line

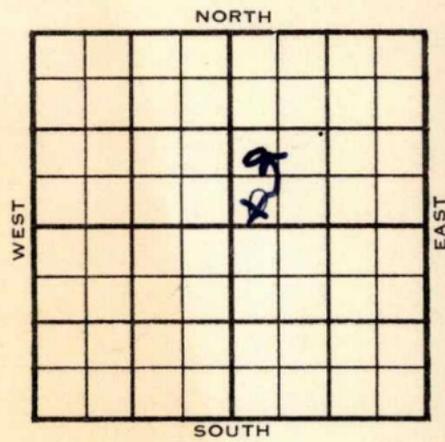

~~SW SW NE~~  
 NW SW NE

	ELEVATION	REPORT
1956	1649 DF	

4-25 Location  
 6-13 Spud 6-8-56  
 8 5/8" @205 w/140 sx  
 Drlg. 1720  
 6-20 DST 3240-3305, op 30 min, rec 10' mud  
 BHP 0#  
 DST 3328-50, op 1 hr, ~~xxx~~ 180' gip  
 rec 125' gcm / 30' g & wcm /  
 180' sw  
 BHP 1050'  
 D & A  
 C. 3267', K. 3312', Mz. 3341'  
 TD 3350'

**ABANDONED**

**CORRECTION**

County Rice Elev. 1649 DF  
 Sec. 22 Twp. 20 Rge. 8W  
 Company Sterling Drlg.  
 Farm Name Walton "C" No. 1

TOPS	DEPTH	LOG	DATUM	Loc. in Sec.
Anh.				<u>SW SW NE</u> <u>NW SW NE</u>
Tp.				
H.				
Tr.				
Dg.				
Bl.				
L.				Geol.
K.C.				Contr.
B.K.C.				
Ce.				
C.	<u>3267</u>			Co. tools
M.				
M.				Pool
K.	<u>3312</u>			
Mz.	<u>3341</u>			<u>SW Lyons</u>
Me.				
V.				
S.				
S.				
A.				
R.				
PE.				
G.				
T.D.	<u>3350</u>			

**ABANDONED**

Date Comm. JUN 20 1956

Location MAY 2 '56 MAY 9 '56 MAY 16 '56

MAY 23 '56 MAY 29 '56 JUN 6 '56 JUN 13 '56

Spd 6-8-56 8 5/8 205/140SX  
#1720 JUN 20 '56 DST 3240 - 3305  
ore 30" rec 10' Md BHP 0  
DST 3328-50 1hr @ 180' GIR  
rec 125' GCM + 30' G&W CM +  
180' SW BHP 1050  
D & Q

County Rice Elev. \_\_\_\_\_  
 Sec. 22 Twp. 20 Rge. 8W  
 Company Sterling Drlg.  
 Farm Name Welton "C" No. 1

TOPS	DEPTH	LOG	DATUM
Anh.			
Tp.			
H.			
Tr.			
Dg.			
Bl.			
L.			
K.C.			
B.K.C.			
Ce.			
C.			
M.			
M.			
K.			
Mz.			
Me.			
V.			
S.			
S.			
A.			
R.			
PE.			
G.			
T.D.			

Loc. in Sec. SW SW NE  
 Geol. \_\_\_\_\_  
 Contr. Co. tools  
 Pool SW Lyons  
 APR 25 '56  
 FIRST REPORT

Date Comm. \_\_\_\_\_  
 Location \_\_\_\_\_

MAY 5 1956

R.C.

12

Co.  
 Sec.  
 No.  
 Sec.  
 T.  
 R.