

Well No. 1 Frye

Company Sterling Drlg. & Plains Explor.

NORTH

WEST

EAST

## SOUTH

Rice

KANSAS

SEC.

TWP.

R.

23

20

6W

WELL NO.

1 Frye

FARM

COMPANY

Sterling Drlg &amp; Plains Explor.

CONTRACTOR

Co. Tools

Welch-Bornholdt


Ft. from N. Line

Ft. from S. Line

Ft. from E. Line

Ft. from W. Line

SW SE NE

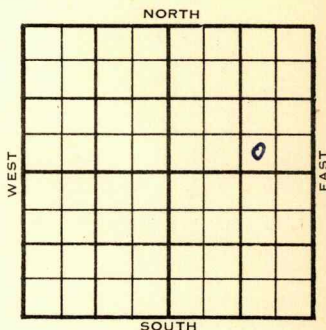

1955

ELEVATION

1545'

REPORT

6/15

Comm 6-10-55

8" @ 129/100

Drlg 1418

8-24

5½" @ 3301 DD 3340, FU 45 go 35 gw  
 frac S/ 91 bf 8 hr. 85 bw Comp. 5 bopd  
 70% wtr.

K.C. 2703, 1158, C. 3240, 1695, M. chat,  
 3300, 1755, T.D. 3305

COMPLETED

County Rice Elev. \_\_\_\_\_  
 Sec. 23 Twp. 20 Rge. 6W  
 Company Sterling Drlg. & Plains Explor.  
 Farm Name Frye No. 1

| TOPS   | DEPTH | LOG | DATUM | Loc. in Sec.    |
|--------|-------|-----|-------|-----------------|
| Anh.   |       |     |       | SW SE NE        |
| Tr.    |       |     |       |                 |
| H.     |       |     |       |                 |
| Tr.    |       |     |       |                 |
| Dg.    |       |     |       |                 |
| Bl.    |       |     |       |                 |
| L.     |       |     |       | Geol.           |
| K.C.   |       |     |       | Contr.          |
| B.K.C. |       |     |       | Co. tools       |
| Ce.    |       |     |       | Pool            |
| C.     |       |     |       | Welch-Bornholdt |
| M.     |       |     |       |                 |
| M.     |       |     |       |                 |
| K.     |       |     |       |                 |
| Mz.    |       |     |       |                 |
| Mq.    |       |     |       |                 |
| V.     |       |     |       |                 |
| S.     |       |     |       |                 |
| S.     |       |     |       |                 |
| A.     |       |     |       |                 |
| R.     |       |     |       |                 |
| Pe.    |       |     |       |                 |
| G.     |       |     |       |                 |
| T.D.   |       |     |       |                 |

FIRST REPORT

JUN 15 '55

Date Comm. 6-10-558" @ 129/100 drlg. 1418

Kt 12

County Rice Elev. 1545  
 Sec. 23 Twp. 20 Rge. 6W  
 Company Sterling Drlg. & Plains Explor.  
 FarmName Frye No. 1

| TOPS           | DEPTH       | LOG | DATUM       |
|----------------|-------------|-----|-------------|
| Anh.           |             |     |             |
| TP.            |             |     |             |
| H.             |             |     |             |
| Tr.            |             |     |             |
| Dg.            |             |     |             |
| BL.            |             |     |             |
| L.             |             |     |             |
| K.C.           | <u>2703</u> |     | <u>1158</u> |
| B.K.C.         |             |     |             |
| Ce.            |             |     |             |
| C.             | <u>3240</u> |     | <u>1695</u> |
| M. <u>chat</u> | <u>3300</u> |     | <u>1755</u> |
| M.             |             |     |             |
| K.             |             |     |             |
| Mz.            |             |     |             |
| Mq.            |             |     |             |
| V.             |             |     |             |
| S.             |             |     |             |
| S.             |             |     |             |
| A.             |             |     |             |
| R.             |             |     |             |
| PE.            |             |     |             |
| G.             |             |     |             |
| T.D.           | <u>3305</u> |     |             |

Loc. in Sec. \_\_\_\_\_

SWSE NE

Geol. \_\_\_\_\_

Contr. \_\_\_\_\_

Co. tools \_\_\_\_\_

Pool \_\_\_\_\_

Welch-Bornhold \_\_\_\_\_

|  |  |  |
|--|--|--|
|  |  |  |
|  |  |  |
|  |  |  |
|  |  |  |
|  |  |  |
|  |  |  |

Date Comm. 6-10-55

AUG 24 1955

8" @ 129/100 5 $\frac{1}{2}$ " @ 3301 DD 3340

FU 45 go 35 gw frac S/ 91 bf 8 hr.

85 bw Comp. 5 bopd 70% wtr.