

**KANSAS**

Company Plains Explor. & Sterling Drlg.

WEST

EAST

## SOUTH

Rice

KANSAS

|      |      |    |
|------|------|----|
| SEC. | TWP. | R. |
| 23   | 20   | 6W |

WELL NO.

#1 Hanson

FARM

COMPANY

Plains Explor. &amp; Sterling Drlg.

CONTRACTOR


## Barnholdt Pool

330 Ft. from N. Line

Ft. from S. Line

330 Ft. from E. Line

Ft. from W. Line

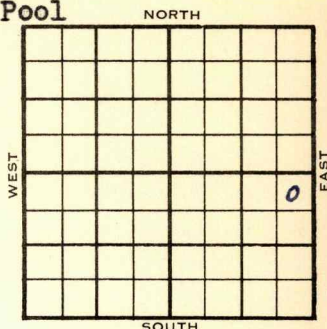

NE NE SE

Texas E/O

1954

ELEVATION

1535'

REPORT

3/10

Location

3/17

8" @ 120' w/100 sks

3/24

KC 2723', Cong 3240', Miss 3293'  
 RTD 3297'  
 5" @ 3296'

3/31

WORTH

4/7

"

5/5

Spud 3-14-54

Oil Well

TD 3329'

8" @ 120'

KC 2723', Cong 3240', Miss 3293'

TD 3297'

5" @ 3296'

DD 3329'

B/134 gw

PB 3315, Hydro.

S/3½ bfph 66% wtr.

S/8 bfph 50% wtr.

Comp. 25 bopd 30% wtr.

COMPLETED

County **Rice** State **Kansas**  
 Sec. **23** (Blk.) **20** (Sur.) **6W** Map No.  
 Operator **Plains Explor. & Sterling Drlg.**  
 Well No. **1** Farm **Hanson**  
 Elev. Location **NE NE SE**

|  |  |  |  |  |  |
|--|--|--|--|--|--|
|  |  |  |  |  |  |
|  |  |  |  |  |  |
**FIRST REPORT**

**330** Ft. From **N** Line **SE**  
**330** Ft. From **E** Line Quarter

1st. Report **MAR 10 1954**

Completion

Remarks **Texas farmout**

Spudding Date

Drlg. Data **Barnholdt Pool**  
**Location**

J. G. McGEHEE

J. G. McGEHEE