


Section 23 Township 20 Range 6W

Well No. #2 Hanson

Company Plains Exploration & Sterling Drlg.

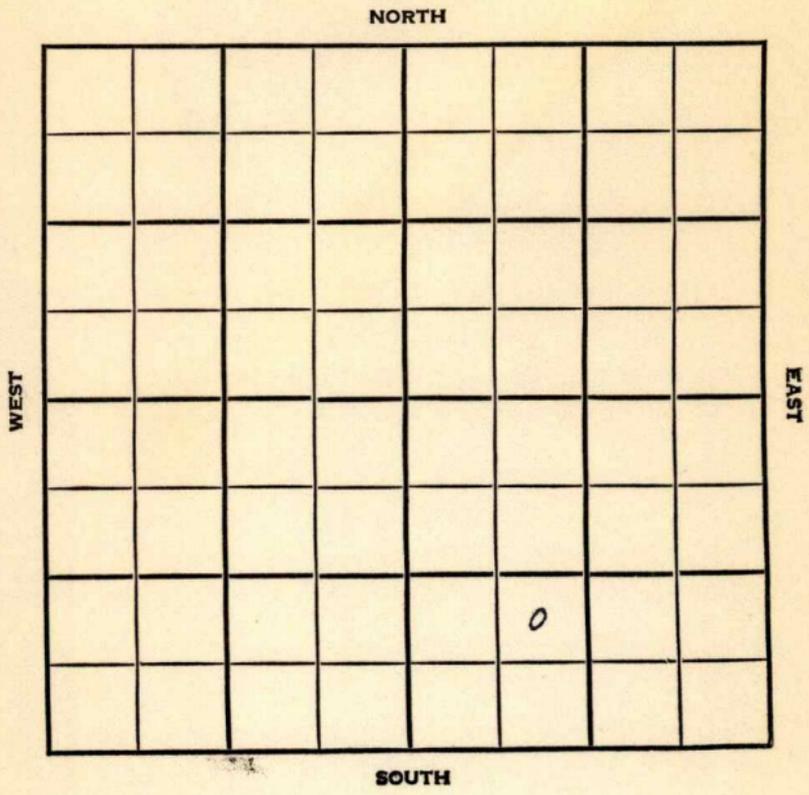

Rice KANSAS

SEC.	TWP.	R.
23	20	6W

WELL NO. 2 Hanson FARM

COMPANY Plains Exploration & Sterling Drlg.

CONTRACTOR Sterling Drlg.


Welch-Bornholt Pool

_____ Ft. from N. Line

990 _____ Ft. from S. Line

_____ Ft. from E. Line

990 _____ Ft. from W. Line

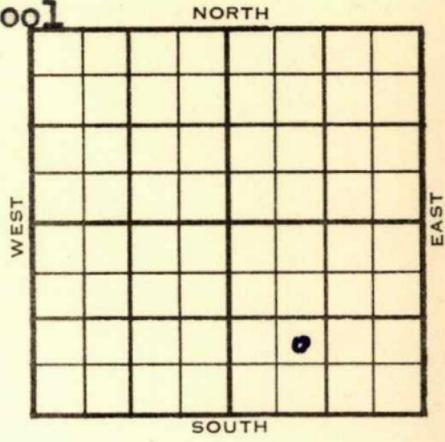

NE SW SE

	ELEVATION	REPORT
1955	1562'	

1/5 Spud 1-1-55
8" @ 120'
Drlg. 880'

2/23 Spud 1-1-55 - Oil Well
TD 3375'
8" @ 120'
Lans. 2751', Cong. 3311', Miss 3322'
TD 3327'
5" @ 3325'
DD 3345' 80 go 90 gw 8 hrs.
DD 3360' DD 3375'
PB 3349'
Sd-frac
S/13 bfph 25% oil
Comp. 72 bopd 240 bw

COMPLETED

