

DX 78-1


McPherson

KANSAS

Section 23 Township 20 Range 2 W

Well No. # 1 Nightengale

Company Mnsgrove Pet.

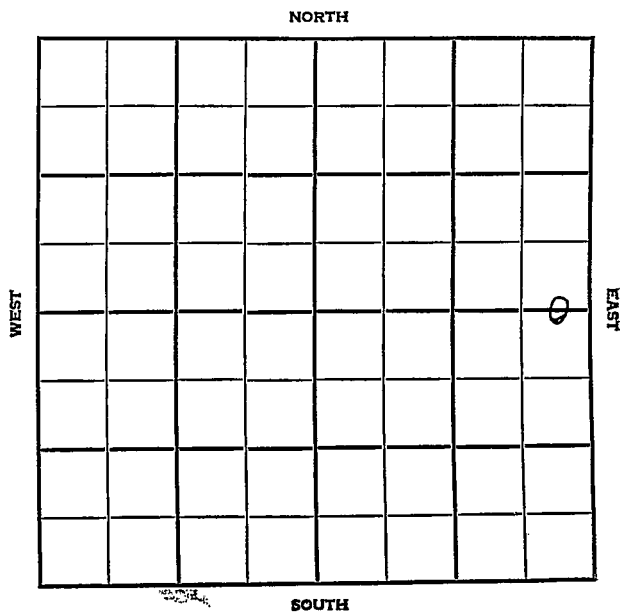

McPherson KANSAS

SEC.	TWP.	R.
23	20	2W

WELL NO. 1 Nightengale FARM

COMPANY

CONTRACTOR Musgrove Petr.


Musgrove  
Wildcat

2640 Ft. from N. Line

\_\_\_\_\_ Ft. from S. Line

330 Ft. from E. Line

\_\_\_\_\_ Ft. from W. Line

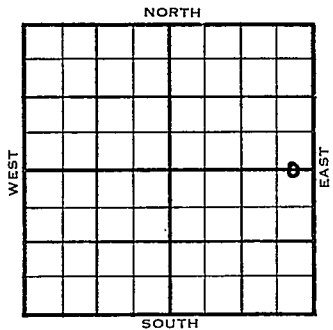

C E/2 E/2 E/2  
Bay - Farmout

1954	ELEVATION	REPORT
	- .	

5/19 Spud 5-14-54  
8" @ 154'  
Drlg. 2540'

5/26 Spud 5-14-54  
D&A  
TD 2985'  
8" @ 154'  
KC 2323', Miss 2940'  
TD 2985'  
D&A

**ABANDONED**

County McPherson State Kansas

Sec. 23 (Blk. Twp.) 20 (Sur. Rge.) 2W Map No.

Operator Musgrove Pat.

Well No. 1 Farm Nightengale

Elev. Location C E $\frac{1}{2}$  E $\frac{1}{2}$  E $\frac{1}{2}$


2640 Ft. From N Line Sec.

330 Ft. From E Line Quarter

1st. Report MAY 1 9 1954

Completion

Remarks Bay - farmout

Musgrove - Contr.

Spudding Date 5-14-54

Drlg. Data Wildcat

8" @ 154 drlg. 2540

J. G. McGEHEE

County McPherson State Kansas

Sec. 23 (Blk. 20) (Sur. 2W) (Rge.) Map No.

Operator Musgrove Pet.

Well No. 1 Farm Nightengale

Elev. Location C E $\frac{1}{2}$  E $\frac{1}{2}$  E $\frac{1}{2}$


2640 Ft. From N Line Sec.

330 Ft. From E Line Quarter

1st. Report

Completion MAY 26 1954

Remarks Wildcat

Musgrove - Contr.

Spudding Date 5-14-54

Drig. Data D & A TD 2985

8" @ 154 KC 2323 Miss. 2940

TD 2985

D & A

