


Section 24 Township 20 Range 6W

Well No. #1 Johnson

Company Mallard Drlg.

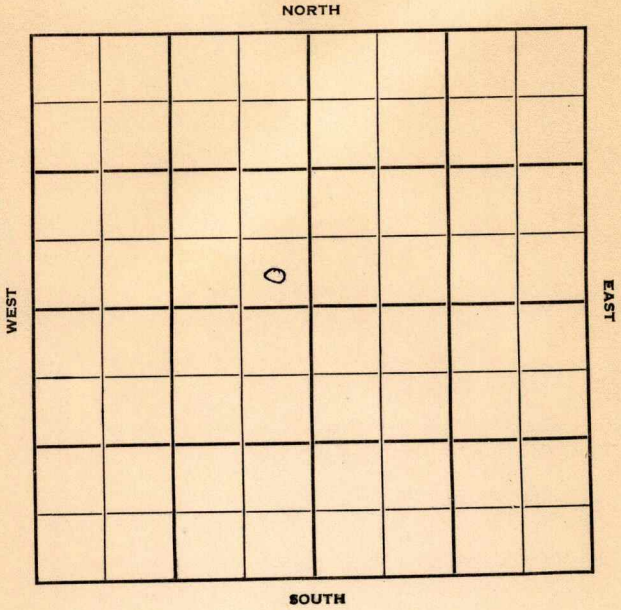

Rice **KANSAS**

Sec. 24 Twp. 20 R. 6 W

Well No. # 1 Johnson Farm

Mallard Drlg. Company

Mallard Contractor


 Ft. from N. Line

330 Ft. from S. Line

330 Ft. from E. Line

 Ft. from W. Line

SE SE NW

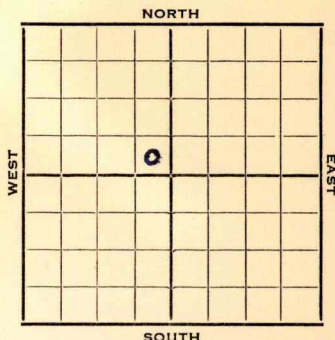

1952

Elev. 1527'

R E P O R T

4/16 Moving In

4/23 Drlg. 2800'
8" @ 151'

4/30 **Miss. 3254** **RTD 3270**
5" @ 3264'


5/7 DD 3290' Fill up 750' oil
DD 3295' TD Hydf.

5/14 NR

5/21 NR

5/28 Spud 4-15-52
Oil Well TD 3295' 8" @ 151'
Miss. 3254 TD 3270' 5" @ 3264
DD 3290 FU 750' oil DD 3295.
Hydro. P/ 3½ boph
Comp. 50 bopd

COMPLETED

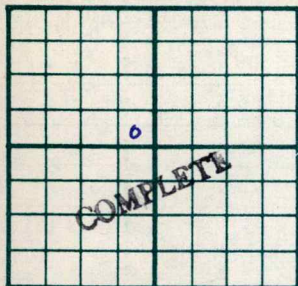County Rice State KansasSec. 24 (Blk. 20 (Sur. 6W (Twp. Rge. Map No.Operator Mallard Drlg.Well No. 1 Farm JohnsonElev. 1527 Location SE SE NW330 Ft. From S Line NW330 Ft. From E Line Quarter

1st. Report

Completion MAY 28 1952

Remarks

Mallard Drlg. - Contr.Spudding Date 4-15-52Drlg. Data Oil well TD 32958" @ 151 Miss. 3254 TD 32705" @ 3264 DD 3290 FU 750' oilDD 3295 Hydro. P/ 3½ bophComp. 50 bopd