

KANSAS

Rice


FORM 51 5M 4-41 PETROL

Section 24 Township 20 Range 6-W

Well No. #1 Johnson

Company Westgate-Greenland

NORTH Bornholdt Pool

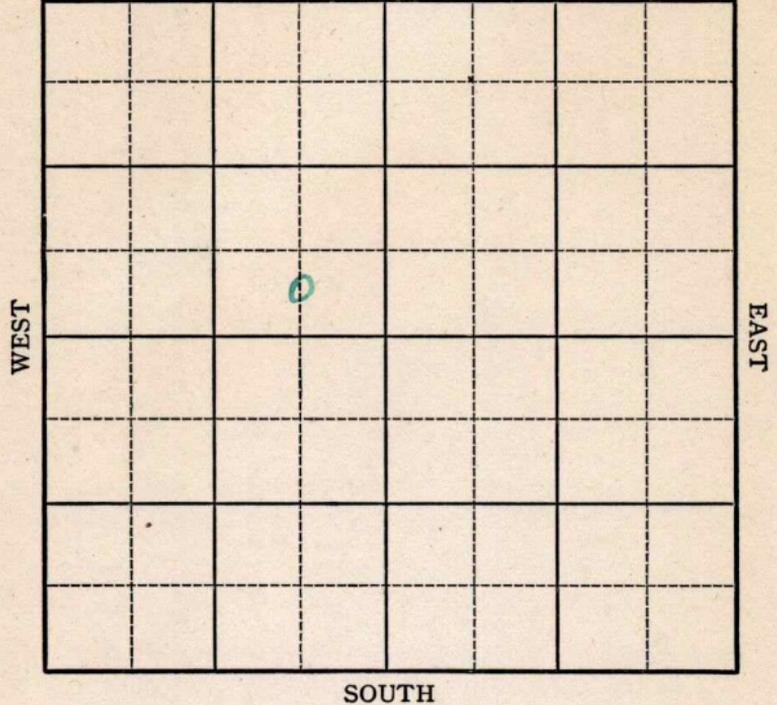

Map No. AP Sec. 24 Twp. 20 R. 6W

Well No. 1 Johnson

Westgate-Greenland Company

FIRST REPORT

Contractor

C SL SE NW


SECTION PLAT

_____ Ft. from N. Line

330 Ft. from S. Line

660 Ft. from E. Line

_____ Ft. from W. Line

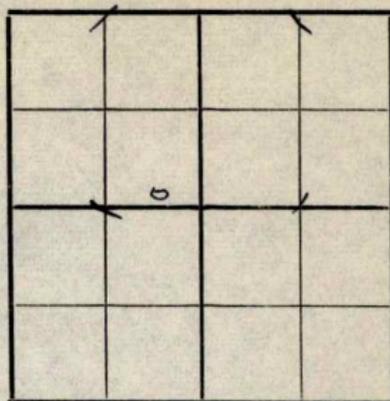

BORNHOLDT POOL

Location _____

Rig up _____

Drilling and Remarks:

Drlg. 1800'

RECORD

Cased _____ in., _____ ft.

Sand _____

Gas _____

Oil _____

Total Depth _____

PRODUCTION

1st 24 hrs. Nat. _____

1st 24 hrs. after shot _____

Gas _____ Cu. Ft.

Dry Hole _____

Abandoned _____

Date

MAY 27 1942

19

S. J. LEWIS Scout

Map No. 48 Sec. 24 Twp. 20 R. 6W

Well No. 1 Johnson

Westgate - Greenland Company

COMPLETED

Contractor

C S L S E N W

SECTION PLAT

_____ Ft. from N. Line

330 Ft. from S. Line

660 Ft. from E. Line

_____ Ft. from W. Line

BORNHOLDT POOL

Location _____

Rig up _____

Drilling and Remarks:

Miss 3262
2" @ 3262
Pump 60 P.S.F.

27 2/3

RECORD

Cased _____ in., _____ ft.

Sand _____

Gas _____

Oil _____

Total Depth 3318.

PRODUCTION

1st 24 hrs. Nat. _____

1st 24 hrs. after shot _____

Gas _____ Cu. Ft.

Dry Hole _____

Abandoned _____

Date

JUN 17 1942 19

S. J. LEWIS

Scout