

Rice


KANSAS

Section 24 Township 20 Range 6-W

Well No. #1 Johnson

Company Westgate - Greenland

NORTH Bornholdt Pool

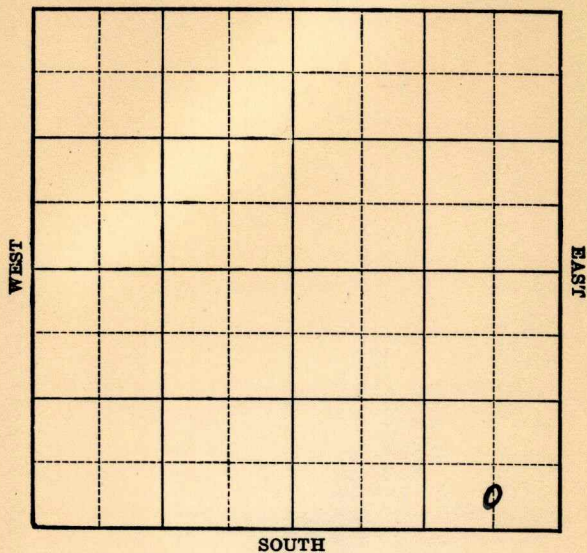

1940
6/5

Chat. 3279'

8" - 3280'

T.D. 3332'

Echometer potential 7586 bbls.

Maximum 3000 bbls.

COMPLETED

KANSAS

Map No. 48 Sec. 24 Twp. 20 R. 6WWell No. 1 JohnsonWestgate Greenland Company

Contractor

COMPLETED

SECTION PLAT

C S L SE SE

 Ft. from N. Line330 Ft. from S. Line660 Ft. from E. Line Ft. from W. Line

BORNHOLDT POOL

			o

Location Rig up

Drilling and Remarks:

*Chas. 3279**8" @ 3280**Echometer Pst.**7586**Max. 3000*

RECORD

Cased in., ft.Sand Gas Oil Total Depth 3332

PRODUCTION

1st 24 hrs. Nat. 1st 24 hrs. after shot Gas Cu. Ft.Dry Hole Abandoned

Date

JUN 5 1940 19

S. J. LEWIS Scout

Rice

KANSAS

Map No. 48 Sec. 24 Twp. 20 R6WWell No. 1 JohnsonWestgate - Greenland


Company

FIRST REPORT

Contractor

C S L SE SE

SECTION PLAT

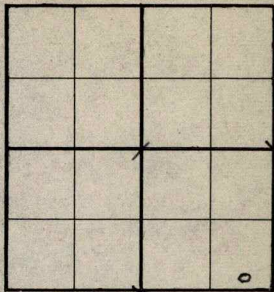 Ft. from N. Line330 Ft. from S. Line660 Ft. from E. Line Ft. from W. Line

BORNHOLDT POOL

Location XRig up

Drilling and Remarks:

RECORD

Cased in., ft.Sand Gas Oil Total Depth

PRODUCTION

1st 24 hrs. Nat. 1st 24 hrs. after shot Gas Cu. Ft.Dry Hole Abandoned

Date

FEB 21 1940

19

S. J. LEWIS

Scout