

# KANSAS

Rice


FORM 51 5M 4-41 PETROL

Section 24 Township 20 Range 6-W

Well No. ~~15~~ 2 Johnson

Company Westgate-Greenland

NORTH Bornholdt pool

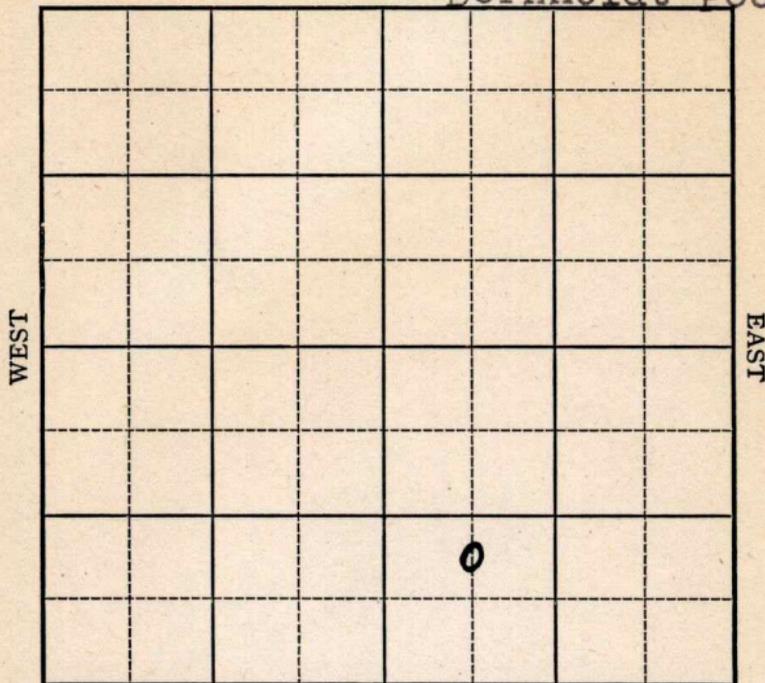

SOUTH

Sec. 24 Twp. 20 R. 6-W

Well No. ~~#8~~ Johnson #5 Farm

Westgate - Greenland Company

(Bornholdt)


\_\_\_\_\_ Ft. from N. Line

990 Ft. from S. Line

\_\_\_\_\_ Ft. from E. Line

660 Ft. from W. Line

**Elev. 1526**

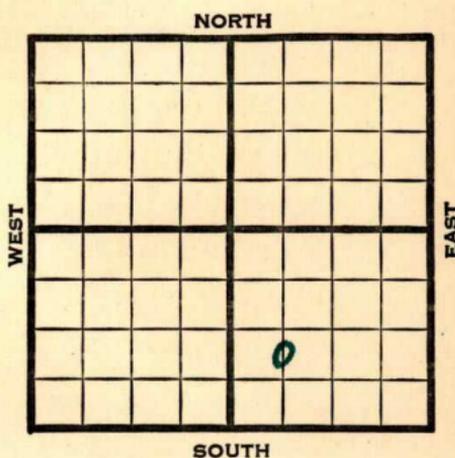

1941	REPORT
8/27	10" - 132' Drlg. 1325'
9/4	<b>Miss. 3268-74'</b> T.D. 7" - 3274' RUST.
9/11	"
9/17	<b>Miss. 3268'</b> 7" - 3274' T.D. 3317' Potential 362 bbls., pump. 37. Gravity
	<b>COMPLETED</b>

Map No. 48 Sec. 24 Twp. 20 R. 6W

Well No. 5 Johnson

Westgate Greenland Company

CORRECTION Contractor

C N L SW SE

\_\_\_\_\_ Ft. from N. Line

990 Ft. from S. Line

\_\_\_\_\_ Ft. from E. Line

660 Ft. from W. Line

BORNHOLDT POOL

**SECTION PLAT**

		o	

Location \_\_\_\_\_

Rig up \_\_\_\_\_

Drilling and Remarks:

Reported as

#3

**RECORD**

Cased \_\_\_\_\_ in., \_\_\_\_\_ ft.

Sand \_\_\_\_\_

Gas \_\_\_\_\_

Oil \_\_\_\_\_

Total Depth \_\_\_\_\_

**PRODUCTION**

1st 24 hrs. Nat. \_\_\_\_\_

1st 24 hrs. after shot \_\_\_\_\_

Gas \_\_\_\_\_ Cu. Ft.

Dry Hole \_\_\_\_\_

Abandoned \_\_\_\_\_

Date

SEP 3 1941 19

S. J. LEWIS Scout



KANSAS

Map No. 48 Sec. 24 Twp. 20 R. 6W

Well No. 3 Johnson (15)

Westgate-Greenland Company

FIRST REPORT Contractor

SECTION PLAT

C N L SW SE

		o	

\_\_\_\_\_ Ft. from N. Line

990 Ft. from S. Line

\_\_\_\_\_ Ft. from E. Line

660 Ft. from W. Line

BORNHOLDT POOL

Location \_\_\_\_\_

Rig up \_\_\_\_\_

Drilling and Remarks:

10" - 132

Drlg. 1325

RECORD

Cased \_\_\_\_\_ in., \_\_\_\_\_ ft.

Sand \_\_\_\_\_

Gas \_\_\_\_\_

Oil \_\_\_\_\_

Total Depth \_\_\_\_\_

PRODUCTION

1st 24 hrs. Nat. \_\_\_\_\_

1st 24 hrs. after shot \_\_\_\_\_

Gas \_\_\_\_\_ Cu. Ft.

Dry Hole \_\_\_\_\_

Abandoned \_\_\_\_\_

Date

AUG 27 1941

19

S. J. LEWIS

Scout