

KANSAS

Rice


Form 51—5M—7-39—Palace

Section 24 Township 20 Range 6W

Well No. #3 Johnson

Company Westgate Greenland

NORTH

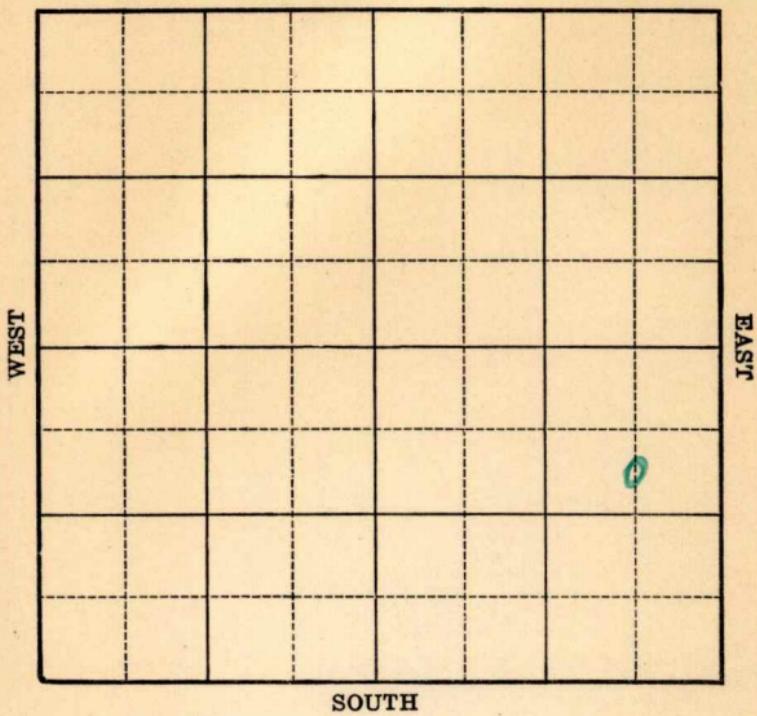

## KANSAS


Rice

FORM 252-A 5M 2-40

Sec. 24 Twp. 20 R. 6-WWell No. #3 Johnson Farm

Westgate Greenland Company

(Bornholdt)

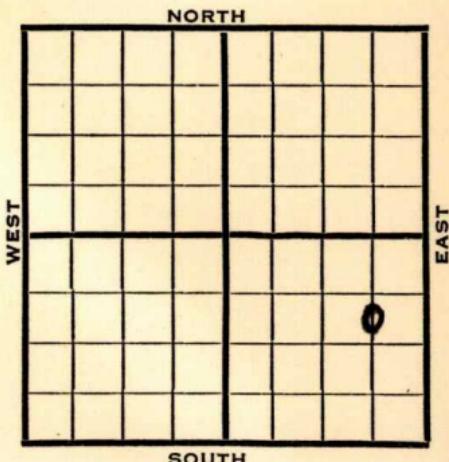990 Ft. from N. Line                   Ft. from S. Line660 Ft. from E. Line                   Ft. from W. Line

Elv. 1526

REPORT	
<u>1940</u>	
<u>7/10</u>	<u>10" - 146'</u>
	<u>423'</u>
<u>7/18</u>	<u>Drlg. 2890'</u>
<u>7/25</u>	<u>Chat. 3276-77' T.D. 5" - 3276'</u>
	<u>RUST.</u>
<u>8/2</u>	<u>"</u>
<u>8/8</u>	<u>"</u>
<u>8/14</u>	<u>T.D. 3362'. 525' fluid 16 hrs.</u>
<u>8/21-</u>	<u>Chat. 3276'</u>
	<u>5" - 3276'</u>
	<u>T.D. 3362'</u>
	<u>Pump 16 bbls.</u>

COMPLETED

Map No. \_\_\_\_\_ Sec. 24 Twp. 20 R. 6W

Well No. 3 Johnson

Westgate Greenland Company

Contractor

## COMPLETED

C S L NE SE

990 Ft. from N. Line


\_\_\_\_\_ Ft. from S. Line

660 Ft. from E. Line

\_\_\_\_\_ Ft. from W. Line

BORNHOLDT POOL

## SECTION PLAT

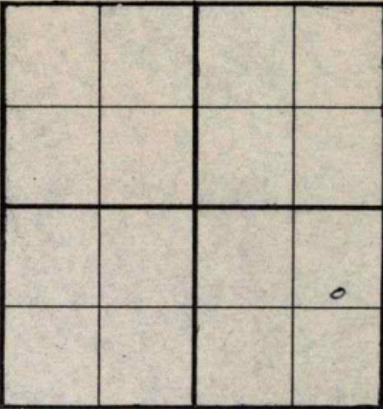

Location \_\_\_\_\_

## RECORD

Cased \_\_\_\_\_ in., \_\_\_\_\_ ft.

Sand \_\_\_\_\_

Gas \_\_\_\_\_

Oil \_\_\_\_\_

Total Depth 3362

## PRODUCTION

1st 24 hrs. Nat. \_\_\_\_\_

1st 24 hrs. after shot \_\_\_\_\_

Gas \_\_\_\_\_ Cu. Ft.

Dry Hole \_\_\_\_\_

Abandoned \_\_\_\_\_

Date

AUG 21 1940 19 \_\_\_\_\_

S. J. LEWIS Scout

Map No. 48 Sec. 24 Twp. 20 R. 6WWell No. 3 Johnson

Westgate Greenland

Company

Contractor

**FIRST REPORT**

C S L N E S E


990 Ft. from N. Line

Ft. from S. Line

660 Ft. from E. Line

Ft. from W. Line

BORNHOLDT POOL

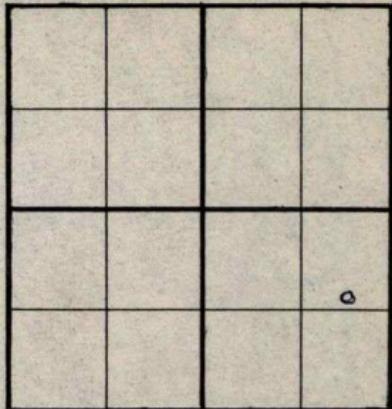**SECTION PLAT**

Location \_\_\_\_\_

**RECORD**

Cased \_\_\_\_\_ in., \_\_\_\_\_ ft.

Sand \_\_\_\_\_

Gas \_\_\_\_\_

Oil \_\_\_\_\_

Total Depth \_\_\_\_\_

Rig up \_\_\_\_\_

Drilling and Remarks:

10" - 146

423

**PRODUCTION**

1st 24 hrs. Nat. \_\_\_\_\_

1st 24 hrs. after shot \_\_\_\_\_

Gas \_\_\_\_\_ Cu. Ft.

Dry Hole \_\_\_\_\_

Abandoned \_\_\_\_\_

Date

JUL 10 1940 19

S. J. LEWIS Scout