


McPherson

KANSAS

SECTION 24 TOWNSHIP 20 RANGE 2W
WELL NO. #1 Moddelmog
COMPANY D. Bond & Lewis Drlg.

NORTH

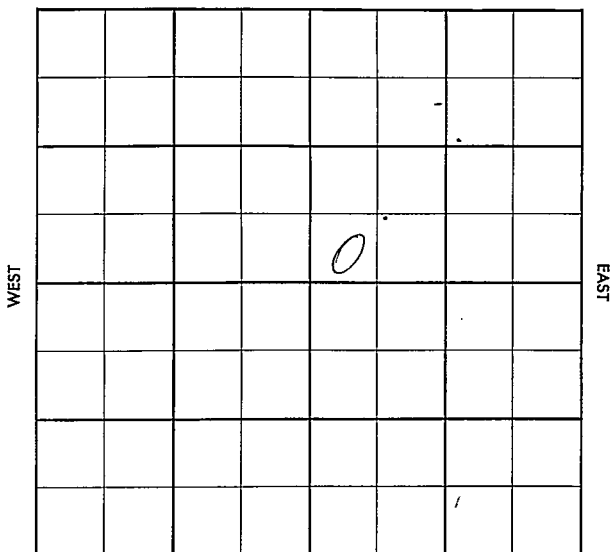

SOUTH

FORM 513 SUNRAY

County McPherson Elev. _____
 Sec. 24 Twp. 20 Rgs. 2W
 Company D. Bond & Lewis Drlg.
 Farm Name Modelmog No. 1

TOPS	DEPTH	LOG	DATUM
Anb.			
Tp.			
H.			
Tr.			
Dg.			
Bl.			
L.			
K.C.			
B.K.C.			
Ce.			
C.			
M.			
M.			
K.			
Mz.			
Me.			
V.			
S.			
S.			
A.			
R.			
Pe.			
G.			
T.D.			

Loc. in Sec. _____
SW SW NE

Geol. _____

Contr. _____
Lewis Drlg.

Pool _____
Widgate

FIRST REPORT

X O X

DEC 12 66

Date Comm.

Location

County McPherson Elev. 1539 Co. 24
 Sec. 24 Twp. 20 Rge. 2W
 Company D. Bond & Lewis Drlg.
 Farm Name Modelmog No. 1

TOPS	DEPTH	LOG	DATUM	Loc. in Sec.
Anh.				SW SW NE
Tp.				
H.				
Tr.				
Dg.				
Bl.				
L.				C. R. Mayfield
K.C.				Geol.
B.K.C.				Contr.
Ce.				Lewis Drlg.
C.				Pool
M. <u>erro</u>	<u>2914</u>			Wildcat
M. <u>solid</u>	<u>2931</u>			
K. <u>V</u>	<u>3181</u>			
Nz.				
Mq.				
V.	<u>3394</u>			
S.	<u>3424</u>			
S. <u>sd</u>	<u>3450-56</u>			
A.				
R.				
Pe.				
G.				
TD.	<u>3458</u>			ABANDONED

Date Comm.

Location DEC 19 56 12-18-56
85/8 160/130 WOC DEC 21 56 11 2655
 JAN 2 57 X erro. MISS 2914 solid MISS 2931
DST 2918-49 or 1hr rec 12' Md BHP 0/20"
Kd 3181 Vis 3394 sp 3424 DST 3398-
3436 or 1hr rec 122' Md BHP 920/20"
sp sd 3450-56 DST 3441-58 or 1hr rec,
710' wt BHP? RTD 3458 Ran Log
D&A R19 stacked