


DX 78-1 Rice

KANSAS

Section 24 Township 20 Range 6W

Well No. #1 Hilda Johnson "A"

Company Mallard Drlg.

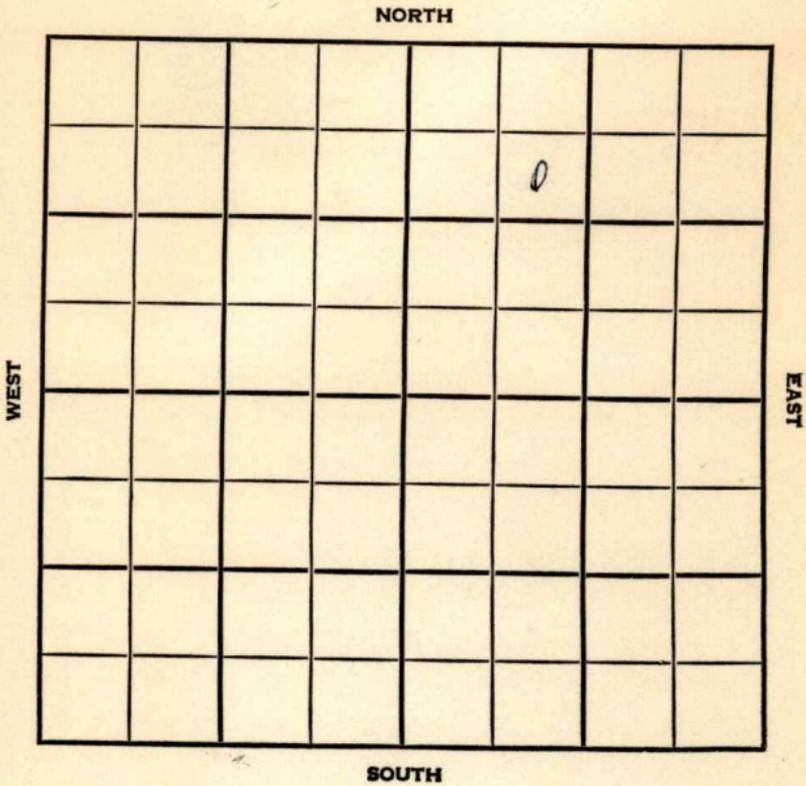

SEC. 24	TWP. 20	R. 6W
------------	------------	----------

WELL NO. _____
 COMPANY 1 Hilda Johnson "A" FARM

CONTRACTOR Mallard Drlg.

Welch-Bornholdt Pool

990 _____ Ft. from N. Line

_____ Ft. from S. Line

_____ Ft. from E. Line

990 _____ Ft. from W. Line

SE NW NE

1954	ELEVATION 1534'	REPORT
------	---------------------------	--------

10/27 Spud 10-20-54
 8" @ 151'
 Drlg. 3060'

11/10 Spud 10-2054 - Oil Well
 TD 3321'
 8" @ 151'
Miss 3262'
 TD 3264'
 5" @ 3264'
 DD 3321'
 Sd-frac
 P/71 bo 15 ?
 Comp. 25 bopd

COMPLETED


County **Rice** State **Kansas**

Sec. **24** (Blk. Twp.) **20** (Sur. Rge.) **6 W** Map No.

Operator **Mallard Drlg.**

Well No. **1** Farm **Hilda Johnson "A"**

Elev. Location **SE NW NE**

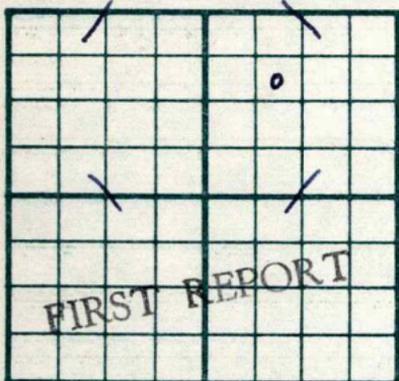

990 Ft. From **N** Line **NE**

990 Ft. From **W** Line Quarter

1st. Report **OCT 27 1954**

Completion

Remarks

Spudding Date **10-20-54**

Drlg. Data **Welch-Bornholdt Pool**

8" @ 151 drlg. 3060

FABEN GILSTRAP


County **Rice** State **Kansas**

Sec. **24** (Blk. Twp.) **20** (Sur. Rge.) **6W** Map No.

Operator **Mallard Drlg.**

Well No. **1** Farm **Hilda Johnson "A"**

Elev. **1534** Location **SE NW NE**

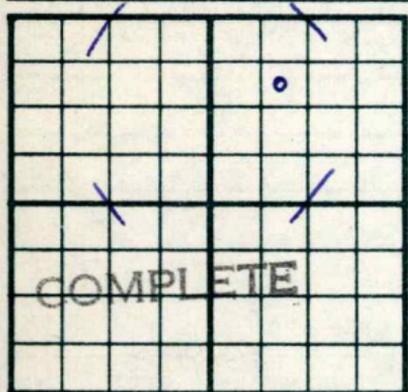

990 Ft. From **N** Line **NE**

990 Ft. From **W** Line **Quarter**

Ist. Report

Completion **NOV 10 1954**

Remarks **Welch-Bornholdt Pool**

Spudding Date **10-20-54**

Drlg. Data **Oil well TD 3321**

8" @ 151 Miss. 3262 TD 3264

5" @ 3264 DD 3321 sd-frac P/71 bo 15

Comp. 25 bopd

FABEN GILSTRAP