


Section 24 Township 20 Range 6W

Well No. 1 Malm

Company Sterling Drlg.

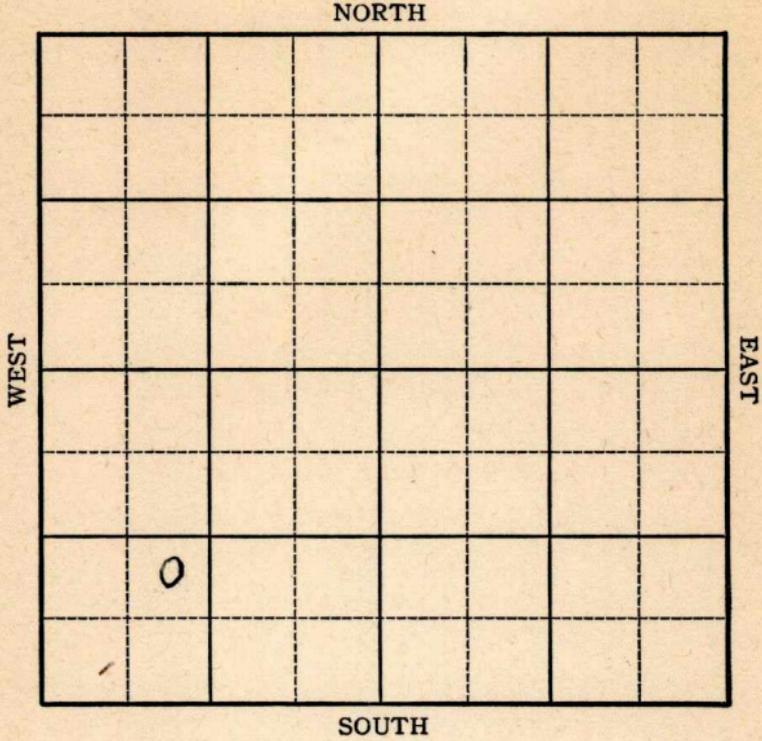

KANSAS

Rice County ✓

Sec. 24 Twp. 20 R. 6W

Well No. #1 Malm Farm _____

Sterling Drlg. Company _____


Bornholdt

_____ Ft. from N. Line

990 Ft. from S. Line

_____ Ft. from E. Line

990 Ft. from W. Line

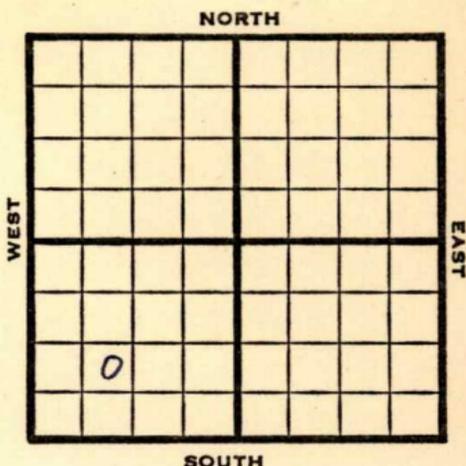

NE SW SW

1946 **Elev 1527'** REPORT

5/8 Location

5/14 **Miss 3274-76 TD**
7" @ 3275 RUST

5/21 TD 3337-40 qts 3294-3324 fsg.

5/29 TD 3337
500 acid.

6/5 " "

6/12 **Miss 3274'**
7" @ 3275
40 qts 3294-3324
500 acid
Pump 16 Pot
39.0 Gr.
TD 3337'

COMPLETED

KANSAS

Kansas Pool Name Bornholdt

Map No. 48 Sec. 24 Twp. 20 R. 6W

Well No. 1 Malm

Sterling Drlg. Company

FIRST REPORT

Contractor

NE SW SW

SECTION PLAT

_____ Ft. from N. Line

990 Ft. from S. Line

_____ Ft. from E. Line

990 Ft. from W. Line

Rice County

Location _____

Rig up _____

Drilling and Remarks:

RECORD

Cased _____ in., _____ ft.

Sand _____

Gas _____

Oil _____

Total Depth _____

PRODUCTION

1st 24 hrs. Nat. _____

1st 24 hrs. after shot _____

Gas _____ Cu. Ft.

Dry Hole _____

Abandoned _____

Date

MAY 8 1946 19 _____

S. J. LEWIS Scout

KANSAS

Pool Name Bornholdt Pool

Map No. 48 Sec. 24 Twp. 20 R. 6W

Well No. 1 Malm

Sterling Drlg. Company

COMPLETED Contractor

NE SW SW

E. 1, 1527
SECTION PLAT

_____ Ft. from N. Line

990 Ft. from S. Line

_____ Ft. from E. Line

990 Ft. from W. Line

Rice County

Location _____

Rig up _____

Drilling and Remarks:

Miss 3274
9" @ 3275
409 to 3294 3324
500 acid
Pump 16 Pst
39 3/4

RECORD

Cased _____ in., _____ ft.

Sand _____

Gas _____

Oil _____

Total Depth 3387

PRODUCTION

1st 24 hrs. Nat. _____

1st 24 hrs. after shot _____

Gas _____ Cu. Ft.

Dry Hole _____

Abandoned _____

Date

JUN 1 2 1946 19

S. J. LEWIS Scout