


Section 24 Township 20 Range 6WWell No. 1 ~~#2~~ MalmCompany Plains Explor. & Sterling Drlg.

NORTH

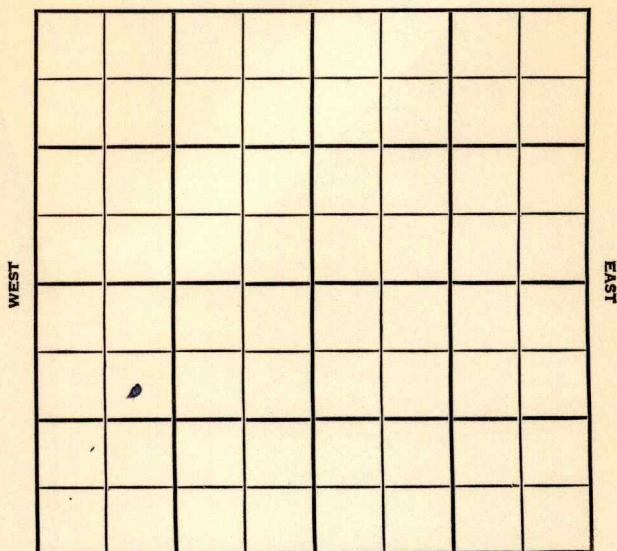

SOUTH

Rice

KANSAS

SEC.	TWP.	R.
24	20	6W

WELL NO.

#2 Malm

FARM

COMPANY

Plains Explor. & Sterling Drlg.

CONTRACTOR

Sterling Drlg.

Welch-Bornholdt Pool


NORTH

990 Ft. from N. Line

Ft. from S. Line

Ft. from E. Line

990 Ft. from W. Line

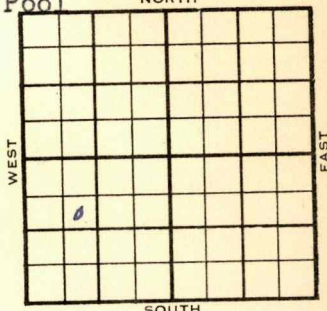

SE NW SW

ELEVATION

REPORT

1954

1527'

10/13 Location

12/15 Spud 10-17-54

Oil Well

TD 3323'

8" @ 102'

KC 2721' Miss 3267

TD 3273'

5" @ 3272'

DD 3323' 1/3 bfph 25% Wtr. SP 3303
frac.

Comp 20 bopd.

COMPLETED

County Rice State Kansas

Sec. 24 (Blk. Twp.) 20 (Sur. Rge.) 6W Map No.

Operator Plains Exploration & Sterling Drlg.

Well No. 1 Farm Malm

Elev.	1527	Location	SE NW SW
-------	------	----------	----------


990 Ft. From N Line SW

990 Ft. From W Line Quarter

1st. Report

Completion DEC 15 1954

Remarks Welch-Bornholdt Pool

Sterling Drlg. - Contr.

Spudding Date 10-17-54

Drilg. Data Oil well TD 3323

8" @ 102 KC 2721 Miss. 3267

TD 3273 5" @ 3272 DD 3323 1/3 bfph

25% wtr. SP 3303 frac

Comp. 20 bopd

FABEN GILSTR.

County Rice State Kansas
Sec. 24 (Blk.) 20 (Sur.) 6W Map No.
Operator Plains Explor. & Sterling Drlg.
Well No. 2 Farm Malm
Elev. _____ Location SE NW SW

990 Ft. From N Line SW
990 Ft. From W Line Quarter

1st. Report OCT 13 1954

Completion _____

Remarks _____

Sterling Drlg. - Contr.

Spudding Date _____

Drlg. Data Welch-Bornholdt Pool

Location

FABEN GILSTRAP

Kansas


Map No. _____ Sec. 24 Twp. 20 R. 6WWell No. 1 Malm

Plains Explor. & Sterling Company

Contractor

SE NW SW

SECTION PLAT

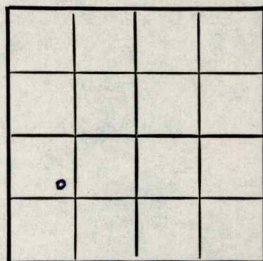990 Ft. from N. Line

_____ Ft. from S. Line

_____ Ft. from E. Line

990 Ft. from W. Line

Rice County

Location _____

Rig up _____

Drilling and Remarks:

Reported

#2 Malm

RECORD

Cased _____ in., _____ ft.

Sand _____

Gas _____

Oil _____

Total Depth _____

PRODUCTION

1st 24 hrs. Nat. _____

1st 24 hrs. after shot _____

Gas _____ Cu. Ft.

Dry Hole _____

Abandoned _____

Date

OCT 20 1954

19

FABEN GILSTRAP Scout