

FORM 51 25M 3-49 PETROL

Section 24 Township 20 Range 6W

Company Don Ingling

WEST

EAST

SOUTH

Rice

KANSAS



Sec. 24 Twp. 20 R. 6 W

Well No. # 3 Nelson Farm

Don Ingling Company

Contractor


330 Ft. from N. Line

Ft. from S. Line

330 Ft. from E. Line

Ft. from W. Line

NE NE NE

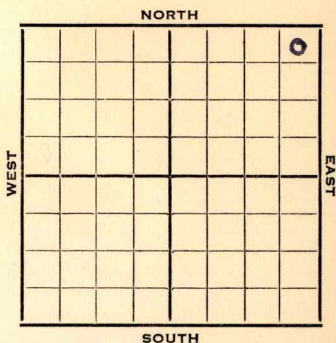

1952

Elev. 1542'

REPORT

7/16

Spud 7-12-52

8" @ 100

Drlg. 620'

7/23

Anhy 665'

Drlg. 2670'

7/30

Miss 3265'

RTD 3280

5" @ 3273'

8/6

Spud 7-12-52

Oil well

TD 3306'

8" @ 100

Anhy 665'

Miss 3265'

TD 3280'

5" @ 3273

DD 3306'

A-frac

S/6 BOPH

Comp. 50 BOPD

40,000 CFG

COMPLETED

8" @ 100 Drlg. 620

~~J. G. McGEHEE~~

County Rice State Kansas

Sec. 24 (Blk. Twp.) 20 (Sur. Rge.) 6W Map No.

Operator Don Ingling

Well No. 3 Farm Nelson

Elev. 1542 Location NE NE NE

0

COMPLETE

330 Ft. From N Line NE

330 Ft. From E Line Quarter

1st. Report

Completion **AUG 6 1952**

Remarks

Spudding Date 7-12-52

Drilg. Data Oil well TD 3306

8" @ 100 Anhy665 Miss. 3265

TD 3280 5" @ 3273 DD 3306

A-Frac S/ 6 boph

Comp. 50 bopd 40,000 cfr

J. G. McGEHEE