


Section 24 Township 20 Range 6W

Well No. #2 Nelson

Company Don Ingling

Bornholdt Pool

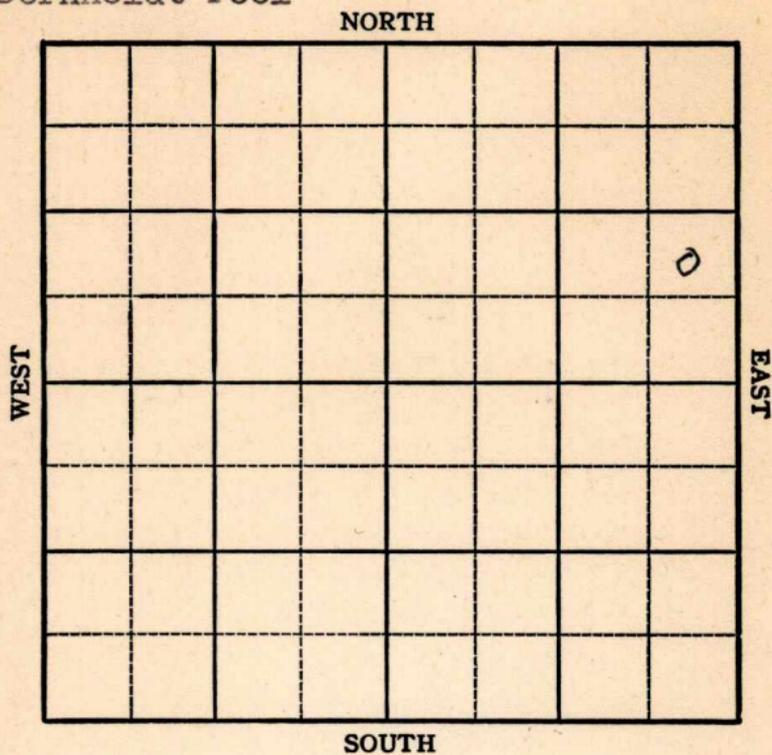

Rice

KANSAS

24

20

6W

Sec. _____ Twp. _____ R. _____

#2 Nelson

Well No. _____ Farm _____

Don Ingling

Company

Bornholdt Pool (Don Ingling, Contr.)

NORTH

_____ Ft. from N. Line

990'


_____ Ft. from S. Line

330'

_____ Ft. from E. Line

_____ Ft. from W. Line

NE SE NE

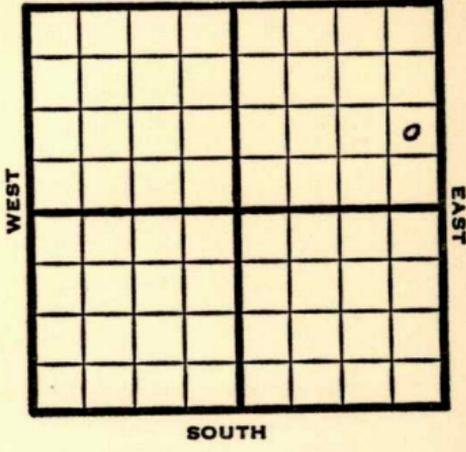

1949 **Elv. 1538'** REPORT

12/21 8" @ 100'

12/28 Drlg 2350'

1950

1/25 8" @ 100'

5" @ 3278'

Miss 3276'

Swb 3 bbls hvy black oil 3 bbls wtr
pr day

TD 3354'

D&A

ABANDONED

Kansas

Map No. _____ Sec. 24 Twp. 20 R. 6W

Well No. 2 Nelson

Don Ingling Company

Don Ingling Contractor

NE SE NE

FIRST REPORT SECTION PLAT

_____ Ft. from N. Line

990 Ft. from S. Line

330 Ft. from E. Line

_____ Ft. from W. Line

			o

Rice County

Location _____

Rig up _____

Drilling and Remarks:

8" @ 100

RECORD

Cased _____ in., _____ ft.

Sand _____

Gas _____

Oil _____

Total Depth _____

PRODUCTION

1st 24 hrs. Nat. _____

1st 24 hrs. after shot _____

Gas _____ Cu. Ft.

Dry Hole _____

Abandoned _____

Date

DEC 21 1949 19

S. J. LEWIS Scout

Map No. _____ Sec. 24 Twp. 20 R. 6W

Well No. 2 Nelson

Don Ingling Company

Contractor

NE SE NE

E1 1538
SECTION PLAT

ABANDONED			
			o

_____ Ft. from N. Line

990 Ft. from S. Line

330 Ft. from E. Line

_____ Ft. from W. Line

Rice County

RECORD

Location _____

Cased _____ in., _____ ft.

Rig up _____

Sand _____

Drilling and Remarks:

Gas _____

8" @ 100

Oil _____

5" @ 3278

Total Depth ~~3307~~ 3354

Miss 3276

PRODUCTION

Swb 3 Bbls HEAVY

1st 24 hrs. Nat. _____

Black oil 3 Bbls wtr
per day - D & A.

1st 24 hrs. after shot _____

Gas _____ Cu. Ft.

Dry Hole _____

Abandoned

Date

JAN 25 1950

19

J. E. TYRA Scout