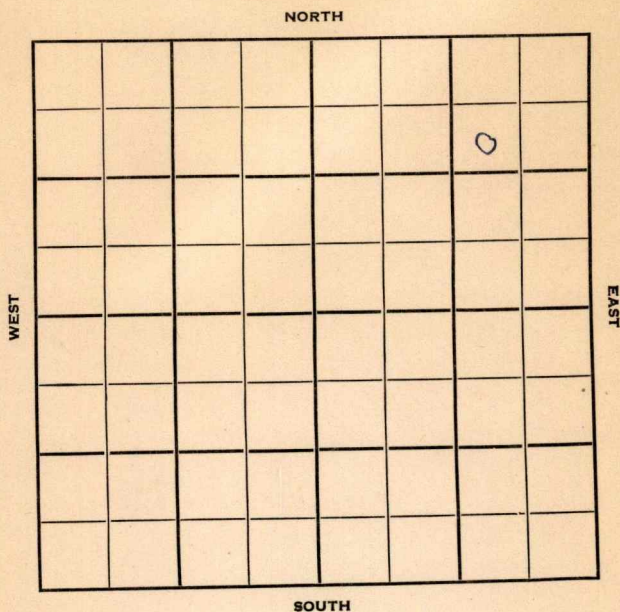


Section 24 Township 20 Range 6WWell No. #4 NelsonCompany Don Ingling

Sec. 24 Twp. 20 R. 6W ✓

Well No. #4 Nelson Farm

Don Ingling Company

" Contractor


990 Ft. from N. Line

Ft. from S. Line

990 Ft. from E. Line

Ft. from W. Line

SW NE NE

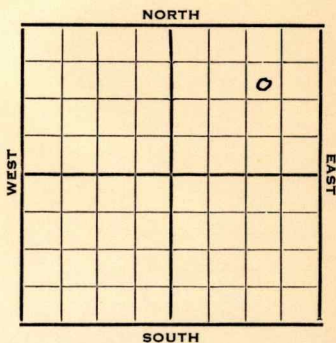

1952 Elev. 1553' REPORT

9/10 RU
9/17 8" @ 102'
Drlg. 2218'

9/24 Drlg. 3207

10/1 B Penn 3278 Miss 3281
RTD 3293 5" @ 3286' DD 3341
TD 5/10 galoph, fill up 200' oil
Hyd. S/10 boph

10/8 Spud 9-9-52
Oil Well TD 3341'
8" @ 102 B. Penn 3278 Miss. 3281
TD 3293' 5" @ 3286 DD 3341
8" @ 102'
B. Penn 3278 Miss. 3281
TD 3293 5" @ 3286 DD 3341
S/ 10 goph FU 200' oil Hydro.
S/ 10 boph Comp. 25 bopd

COMPLETED

County **Rice** State **Kansas**
Sec. **24** (Blk. **20** (Sur. **6W** Map No.
(Twp.) (Rge.)
Operator **Don Ingling**
Well No. **4** Farm **Nelson**
Elev. Location **SW NE NE**

FIRST REPORT

990 Ft. From **N** Line **NE**
990 Ft. From **E** Line Quarter

1st. Report **SEP 10 1952**

Completion

Remarks

Don Ingling - Contr.

Spudding Date

Drlg. Data

RU

J. G. McGEHEE

County Rice State Kansas

Sec. 24 (Blk. Twp.) 20 (Sur. Rge.) 6W Map No.

Operator Don Ingling

Well No. 4 Farm Nelson

Elev.	1553	Location	SW NE NE
-------	------	----------	----------

0

COMPLETE

990 Ft. From N Line NE

990 Ft. From E Line Quarter

1st. Report

Completion OCT 8 1952

Remarks

Don Ingling - Contr.

Spudding Date 9-9-52

Drilg. Data Oil well TD 3341

8" @ 102 B. Penn 3278 Miss. 3281

TD 3293 5" @ 3 286 DD 3341 S/ 10 goph

FU 200' oil Hydro. S/ 10 boph

Comp. 25 bopd

J. G. McGEHEE