


Section 24 Township 20S Range 6W

Well No. 5 Nelson

Company D. T. Ingling et al

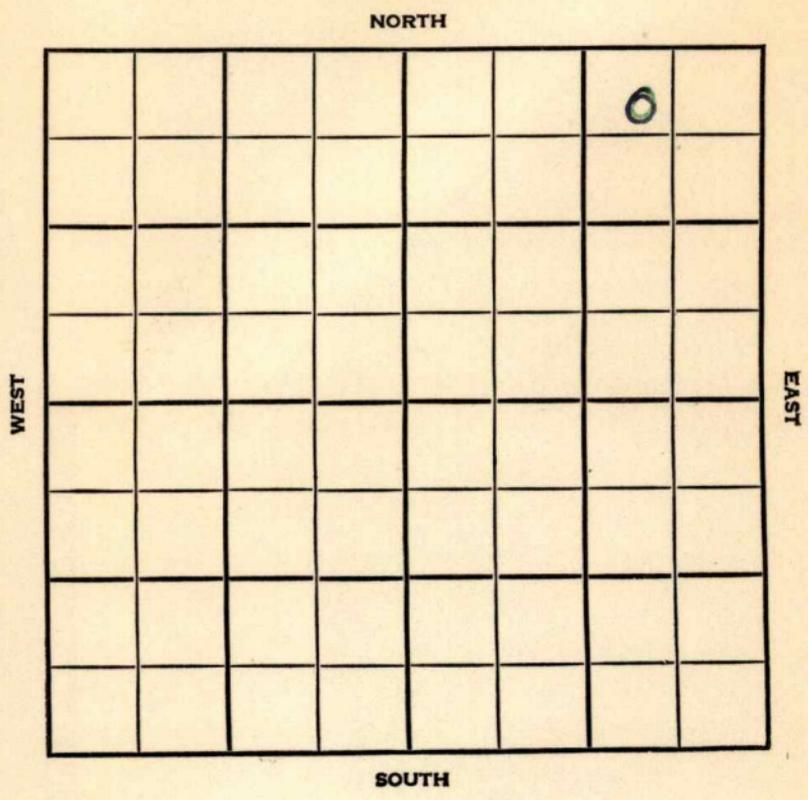

Rice

KANSAS

SEC. 24	TWP. 20S	R. 6W
------------	-------------	----------

WELL NO.

#5 Nelson FARM  
COMPANY

D. T. Ingling et al  
CONTRACTOR

Welsh  
Bonnholt


\_\_\_\_\_ Ft. from N. Line

\_\_\_\_\_ Ft. from S. Line

\_\_\_\_\_ Ft. from E. Line

\_\_\_\_\_ Ft. from W. Line

NW NE NE

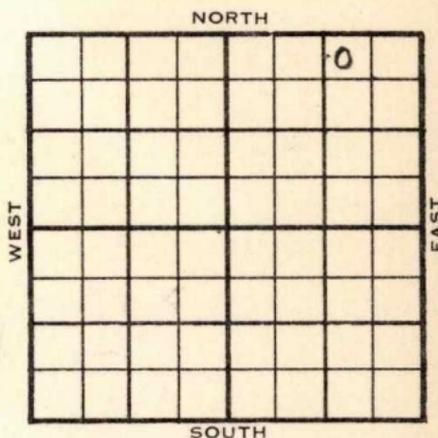

1955	ELEVATION	REPORT
	<del>1556</del> 1556	1558 RB

7/1 MIRT

8/10  
Comm 7/6/55  
C. Weath 3275  
M 3280  
TD 3284  
8 5/8" @ 101 w/60  
5 1/2" @ 3282 w/75 P 2 boph nt  
P 25 bopd no wtr

COMPLETED

County **Rice** Elev. \_\_\_\_\_  
 Sec. **24** Twp. **20S** Rge. **6W**  
 Company **D. T. Ingling etal**  
 Farm Name **Nelson** No. **5**

TOPS	DEPTH	LOG	DATUM
Anh.			
Tp.			
H.			
Tr.			
Dg.			
Bl.			
L.			
K.C.			
B.K.C.			
Ce.			
C.			
M.			
M.			
K.			
Mz.			
Me.			
V.			
S.			
S.			
A			
R.			
Pe.			
G.			
TR.			

Loc. in Sec. **NW NE NE**

Geol. \_\_\_\_\_  
 Contr. \_\_\_\_\_

Pool **Welch**  
**Bornholdt**

**FIRST REPORT**  
 JUL 6 '53

Date Comm. **MIRT**

*12*

Co.

Lse.

No.

Sec.

T.

R.

County Rice Elev. 1556 1558 RB Co  
 Sec. 24 Twp. 20 Rge. 6W  
 Company D.T. Ingling etal  
 FarmName Nelson No. 5

TOPS	DEPTH	LOG	DATUM
Anh.			
Tp.			
H.			
Tr.			
Dg.			
Bl.			
L.			
K.C.			
B.K.C.			
Ce.			
C. <i>weath</i>	<i>3275</i>		<i>1719</i>
M.	<i>3280</i>		<i>1724</i>
M.			
K.			
Mz.			
Mq.			
V.			
S.			
S.			
A.			
R.			
PE.			
G.			
T.D.	<i>3284</i>		

Loc. in Sec. NW NE NE  
 Geol. \_\_\_\_\_  
 Contr. \_\_\_\_\_  
 Pool Welch  
Bornholdt  
 Aug 1 0 1955  
**COMPLETE**

Date Comm. 7/6/55 8 5/8" 101 w/60  
5 1/2" 3282 w/75 P 2 boph nt  
P 25 bopd no wtr

Co.  
 Lse.  
 No.  
 Sec.  
 T.  
 R.