


Section 24 Township 20 Range 6 W

Well No. # 2 Wernet

Company Braden Drlg.

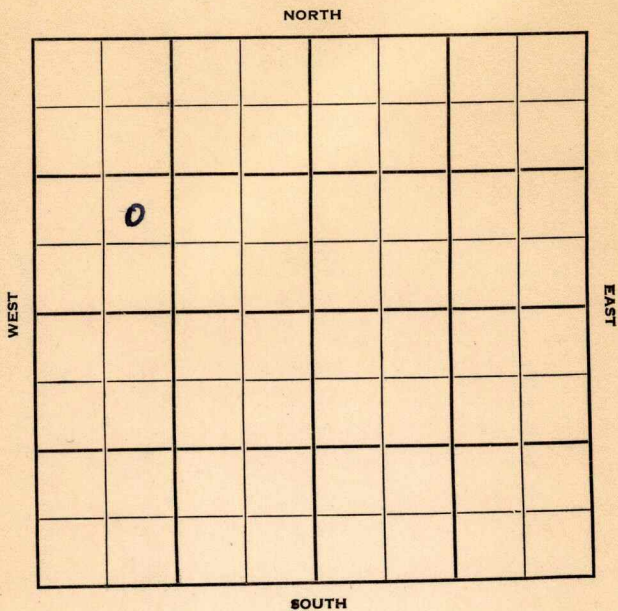

KANSAS

Rice

Sec. 24 Twp. 20 R. 6W

Well No. #2 Wernet Farm

Braden Drlg. Company

Braden - Contr. Contractor


Ft. from N. Line

990' Ft. from S. Line

Ft. from E. Line

990' Ft. from W. Line

NE SW NW

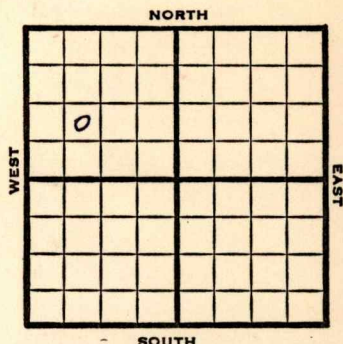

1952 **Elev. 1531** REPORT

5/21 Spud 5-13-52
8" @ 137
TD 2600
Twist off

5/28 **Miss 3274** RTD 3294
5" @ 3294'


6/11 **DB** DD 3315' TD Fill up wtr
24/3282-90 22/3280-88 SSO & W
PB 3287' Hyd. S/2 BFPH 90% wtr.

6/18 CO 3291 Sd-frac S/5 BOPH for 12
hrs POP

6/25 NR
7/2 NR

7/9 Spud 5-13-52
Oil Well TD 3315
8" @ 137 **Miss 3274** TD 3294
5" @ 3294 DD 3315 FU wtr
24/3282-90 22/3280-88 SO & W
PB 3287 Hydro S/2 bfph 90% wtr
CO to 3291 Stratofrac S/5 boph
Comp. 40 bopd

COMPLETED

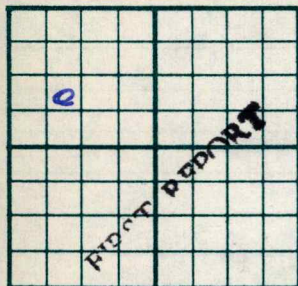County Rice State KansasSec. 24 (Blk.) 20 (Sur.) 6W Map No.Operator Braden Drlg.Well No. 2 Farm WernetElev. Location NE SW NW990 Ft. From S Line NW990 Ft. From W Line Quarter1st. Report MAI 21 1952

Completion

Remarks

Braden - Contr.Spudding Date 5-13-52

Drlg. Data


8" @ 137 TD 2600 Twist offJ. G. McGEHEE

County Rice State Kansas
 Sec. 24 (Blk.) 20 (Sur.) 6W Map No.

Operator Braden Drlg.

Well No. 2 Farm Wernet

Elev. 1531 Location NE SW NW

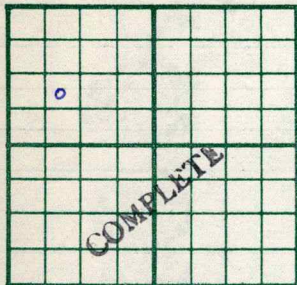

990 Ft. From S Line NW

990 Ft. From W Line Quarter

1st. Report

Completion JUL 9 1952

Remarks

Braden Drlg. - Contr.

Spudding Date 5-13-52

Drlg. Data Oil well TD 3315

8" @ 137 Miss. 3274 TD 3294

5" @ 3294 DD 3315 FU water

24/ 3282-90 22/ 3280-88 SO & W

PB 3287 Hydro. S/ 2 bph 90% wtr.

CO to 3291 Stratofrac S/ 5 boph

Comp. 40 bopd