


Section 25 Township 20 Range 6-W

Well No. #1 Hodge

Company W. C. McBride

NORTH Bornholdt Pool

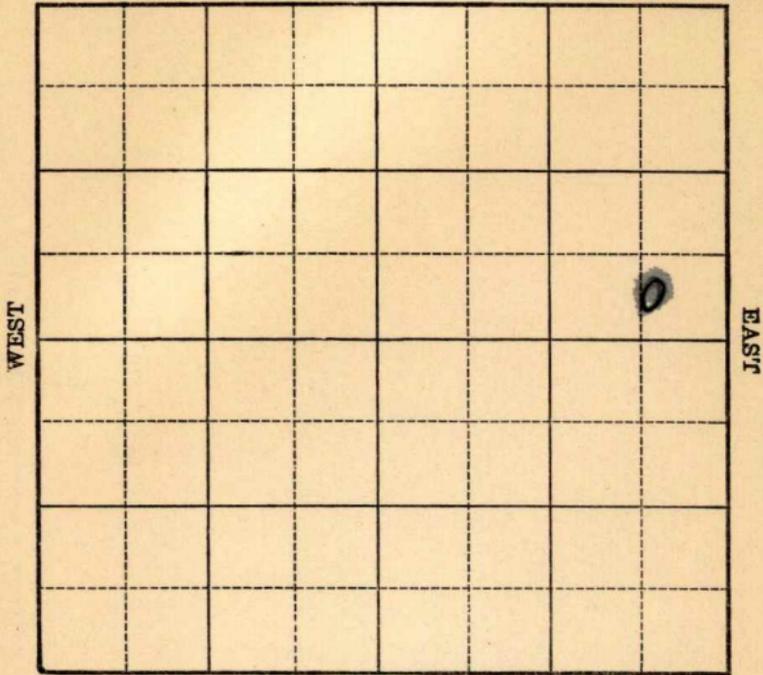

SOUTH

Sec. 25 Twp. 20 R. 6-W

Well No. #1 Hodge Farm

W. C. McBride Company


(Bornholdt)

_____ Ft. from N. Line

410
~~330~~ Ft. from S. Line

590 Ft. from E. Line

_____ Ft. from W. Line

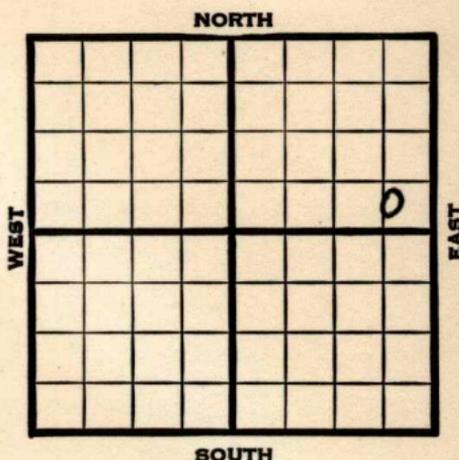

Elev. 1524

1939	REPORT
11/22	Rotary.
11/27	Surface hole (Tel)
11/29	13" - 152' WOC.
12/7	Drlg. 2600'
12/8	Dlg. 3120 (Tel)
12/11	Top Chat 3274 TD 3282 Running pipe Small stain oil in cuttings (Tel)
12/14	Miss. 3273' 8" - 3278' T.D. 3282' RUST.
12/16	Top Miss or Chat 3273 8" 3278 Drilled to 3319 1100' oil in hole 18 hrs. 1/2 bailer water per hr. Think water exhausting (Tel)
12/21	450' oil 12 hrs. at 3316' At 3316' 1050' oil 18 hrs. 1/2 B.W. T.D. 3325½' H.F.O.
12/28	Swab 171 bbls. 8 hours. 1400' off bottom.
1940	
1/4	Pump 238 bbls. 8 hours.

OVER

1940
1/10

Chat. 3273'

8" - 3278'

T.D. 3325½'

Potential 710 bbls. on pump.

COMPLETED

Map No. 48 Sec. 25 Twp. 20 R. 6W

Well No. 1 Hodge

W. C. McBride Company

Contractor

FIRST REPORT

SECTION PLAT

C S L S E N E

Ft. from N. Line

330 Ft. from S. Line

590 Ft. from E. Line

Ft. from W. Line

BORNHOLDT POOL

			o

Location _____

Rig up _____

Drilling and Remarks:
Rotary

RECORD

Cased _____ in., _____ ft.

Sand _____

Gas _____

Oil _____

Total Depth _____

PRODUCTION

1st 24 hrs. Nat. _____

1st 24 hrs. after shot _____

Gas _____ Cu. Ft.

Dry Hole _____

Abandoned _____

Date

NOV 22 1939

19

S. J. LEWIS

Scout

Rice

KANSAS

Map No. 48 Sec. 25 Twp. 20 R. 6W

Well No. 1 Hodge

W. C. McBride Inc. Company

Correction Contractor

SECTION PLAT

C S L SE NE

 Ft. from N. Line

410 Ft. from S. Line

590 Ft. from E. Line

 Ft. from W. Line

			e

BORNHOLDT POOL

RECORD

Location

Cased in., ft.

Rig up

Sand

Drilling and Remarks:

Gas

Reported

Oil

Total Depth

330' from S. Line

PRODUCTION

1st 24 hrs. Nat.

1st 24 hrs. after shot

Gas Cu. Ft.

Dry Hole

Abandoned

Date

DEC 6 1939

19

S. J. LEWIS

Scout

Map No. 48 Sec. 25 Twp. 20 R. 6W

Well No. 1 Hodge

W. C. McBride Company

Contractor

COMPLETED

C S L S E N E

_____ Ft. from N. Line

410 Ft. from S. Line

590 Ft. from E. Line

_____ Ft. from W. Line

SECTION PLAT

BORNHOLDT POOL

Location _____

Rig up _____

Drilling and Remarks:

Chas Y 3273

8" @ 3278

Pump 710 P.O.T.

RECORD

Cased _____ in., _____ ft.

Sand _____

Gas _____

Oil _____

Total Depth 3325 1/2

PRODUCTION

1st 24 hrs. Nat. _____

1st 24 hrs. after shot _____

Gas _____ Cu. Ft.

Dry Hole _____

Abandoned _____

Date

JAN 10 1940 19

S. J. LEWIS

Scout